

MONTGOMERY COLLEGE - OFFICE OF PROCUREMENT
MACKLIN TOWER MBI FINANCE LAB SUITE 100, ROCKVILLE CAMPUS
RFP NO.: 620-011
RFP CLOSING DATE AND TIME: APRIL 7, 2020 @ 3:00 PM

ADDENDUM #1
Issued: March 27, 2020

THIS ADDENDUM IS TO PROVIDE ANSWERS TO THE FOLLOWING QUESTIONS:

NOTE: Similar requests for information that were received from different Contractors have been grouped under a single addendum item where appropriate, with a single comprehensive answer provided.

The following items offer clarifications that do not change any requirements of the RFP documents.

Item 2-1 Question: E5.02 Detail Notes. Please confirm that access to an on-site client workstation to perform these steps, by a factory authorized Lenel VAR, will be made available by Montgomery College.

Answer: The College will provide a connection to the server from a MCFNet connected workstation, vendor must be onsite to connect.

Item 2-2 Question: E5.02 Detail Notes. Please confirm that all necessary software licenses for the additional readers locations being installed are existing.

Answer: Software licenses for additional readers are available in the software already.

The following items offer clarification that do change the requirements of the RFP documents. PLEASE MAKE CHANGES TO THE RFP DOCUMENTS AS FOLLOWS:

Item 2-3 Question: E5.02 Detail Notes: Please clarify labor scope described here. If the ACUXL 16 Plus Intelligent Controller, LFSP FPO150/250 Cabinet, and Spare Lenel RRE-4 modules are existing, some of the scope items described will not be required. Specifically, related to Note 5 – since the devices are existing (and presumed online) there will be no programming required to connect the system into the College Central System.

Answer: ACUXL16 Plus and FPO150/250 are existing, RRE-4s will need to be provided. ACU is connected to system currently so no programming is needed for this, but the RRE-4s will need to be programmed into the system.

Item 2-4 Question: E5.02, In Note 4 there are references to additional system design, shop drawings, calculations and programming. The scope of work as defined has both component and system design requirements already specified, and the RRE-4 control devices already installed in Rm MT0026C. Please clarify if this representation is accurate. Our understanding is that this will limit the scope of Note 4 to the programming needed to name/activate the new door devices being terminated on these existing boards, and configuring/testing their operation.

Answer: RRE-4s will need to be programmed in the system.

MONTGOMERY COLLEGE - OFFICE OF PROCUREMENT
MACKLIN TOWER MBI FINANCE LAB SUITE 100, ROCKVILLE CAMPUS
RFP NO.: 620-011
RFP CLOSING DATE AND TIME: APRIL 7, 2020 @ 3:00 PM

ADDENDUM #1
Issued: March 27, 2020

Item 2-5 Question: Refer to Specification Section 087100 Door Hardware, Page 15. Per Sheet E5.02, the 2 Lenel RRE-4 controls are existing. Please confirm these do not need to be provided as part of the hardware spec.

Answer: RRE-4 controllers will need to be provided. The ACUXL16 Plus and FPO150/250 are existing.

Item 2-6 Question: Refer to Specification Section 087100 Door Hardware, Page 14. Set #2 – shows as being used for Door 002, and does not indicate Electrified Hardware. However, A601 Door Schedule identifies HW Set #1 for Door 002. Please Clarify.

Answer: Door 002 is not a locking door and should use Hardware Set #2.

Item 2-7 Question: Refer to Specification Section 087100 Door Hardware, Page 14. Set #3 – shows one HID Reader. Based on lock Specification ML20932 x SEC and Drawing E2.01, it assumed this door requires both Entry and Exit Readers. Please Clarify.

Answer: Yes, this hardware set should have had 2 readers on it.

Item 2-8 Question: Our team went over the construction document and discover some inconsistency in the labeling of Drawing Index and E4.01 FRIST FLOOR PLAN-FIRE ALARM-NEW WORK is missing in the construction document.

Answer: The electrical section of the drawing index is incorrect. There is no fire alarm plan issued with the RFP documents. The List of Drawings has been reissued in its entirety and included in this Addendum.

Item 2-9 **DELETE** Part 6.2 on Page 002113-4 in its entirety and replace with the following:

6.2 Offerors must submit one original hard copy of Technical Proposal with original ink signatures, plus one electronic version of Technical Proposal saved as a PDF on a clearly marked compact disc (CD) or a clearly marked USB flash drive with the name of the firm and RFP No. The PDF must be a single, appropriately bookmarked and text-searchable PDF. Originals of technical proposal submission should be bound with binder clips or placed in three-ring binders and no spiral binding should be used.

Item 2-10 **DELETE** first paragraph on Page 002413-1 in its entirety and replace with the following:

Proposals, one original hard copy, plus one electronic version of Technical Proposal (Part A) saved as a PDF on a clearly marked compact disc (CD) or a clearly marked USB flash drive with the name of the firm and RFP No., and one original and two copies of Price Proposal (Part B) shall be submitted on the enclosed Proposal Forms, properly signed with the required attachments, if any, in the separately sealed envelopes and address to:

MONTGOMERY COLLEGE - OFFICE OF PROCUREMENT
MACKLIN TOWER MBI FINANCE LAB SUITE 100, ROCKVILLE CAMPUS
RFP NO.: 620-011
RFP CLOSING DATE AND TIME: APRIL 7, 2020 @ 3:00 PM

ADDENDUM #1
Issued: March 27, 2020

Item 2-11 **ADD** Specification Section 237313 INDOOR AIR HANDLING UNITS to the project manual.

Item 2-12 **EXTEND** the RFP closing date and time from 3:00 p.m. on April 1, 2020 to **3:00 p.m. on April 7, 2020.**

Index of Attachments to Addendum

List of Drawings or Portions Reissued in Entirety

LIST OF DRAWINGS

Specification Sections or Portions Reissued in Entirety

237313 Indoor Air Handling Units

Drawings Reissued in Entirety

COVER SHEET

G011 LIFE SAFETY PLANS

S1.01 PLANS & ELEVATIONS

S2.02 SECTIONS & DETAILS

A101 GROUND FLOOR PLAN

A112 FIRST FLOOR RCP

A607 FINISH SCHEDULE AND DETAILS

M0.01 MECHANICAL LEGEND, ABBREVIATIONS AND GENERAL NOTES

M2.01 GROUND FLOOR PLAN – DUCTWORK – NEW WORK

M2.02 FIRST FLOOR PLAN – MECHANICAL – NEW WORK

P2.01 FIRST FLOOR PLAN – PLUMBING – NEW WORK

E2.01 – FIRST FLOOR PLAN – POWER & SPECIAL SYSTEMS – NEW WORK

Sketches

NONE

Items Issued for Informational Purposes

BKM Drawing Narrative dated 3/25/2020



Patrick Johnson, MBA
Director of Procurement

Please **sign** below to acknowledge receipt of this Addendum and return with the **Technical Proposal submission**. Failure to return this Acknowledgement of Addendum may deem a proposal nonresponsive.

MONTGOMERY COLLEGE - OFFICE OF PROCUREMENT
MACKLIN TOWER MBI FINANCE LAB SUITE 100, ROCKVILLE CAMPUS
RFP NO.: 620-011
RFP CLOSING DATE AND TIME: APRIL 7, 2020 @ 3:00 PM

ADDENDUM #1
Issued: March 27, 2020

NOTE: ACKNOWLEDGEMENT OF RECEIPT OF RFP ADDENDA WILL NOT BE ACCEPTED BY FACSIMILE OR E-MAIL.

Company Name

Authorized Signature

Date

Printed/Typed Signature

LIST OF DRAWINGS

GENERAL

G0.00 – COVER SHEET
G0.11 – SAFETY PLANS

STRUCTURAL

S0.01 – STRUCTURAL GENERAL NOTES & SPECIAL INSPECTION SCHEDULE
S1.01 – STRUCTURAL PLAN & ELEVATIONS
S2.01 – STRUCTURAL SECTIONS & DETAILS
S2.02 – STRUCTURAL SECTION & DETAILS

ARCHITECTURAL

A0.01 – LEGENDS, SYMBOLS & ABBREVIATIONS
A0.12 – PARTITION TYPES
A0.15 – TYPICAL PARTITION DETAILS
AD1.01 – DEMOLITION PLAN – GROUND FLOOR
AD1.02 - DEMOLITION PLAN – FIRST FLOOR
AD1.11 – DEMOLITION RCP – GROUND FLOOR
AD1.12 – DEMOLITION RCP – FIRST FLOOR
A1.01 – GROUND FLOOR PLAN
A1.02 – FIRST FLOOR PLAN
A1.12 – REFLECTED CEILING PLAN – FIRST FLOOR
A4.01 – ENLARGED PLANS & ELEVATIONS
A6.01 – DOOR SCHEDULES
A6.02 – FINISH SCHEDULE AND DETAILS
A6.03 – FINISH PLAN AN DSCHEDULE

MECHANICAL

M0.01 – MECHANICAL LEGEND ABBREVIATION AND GENERAL NOTES
M1.01 – GROUND FLOOR PLAN – MECHANICAL – DEMOLITION
M1.02 – FIRST FLOOR PLAN – MECHANICAL – DEMOLITION
M2.01 – GROUND FLOOR PLAN – DUCTWORK – NEW WORK
M2.02 – FIRST FLOOR PLAN – DUCTWORK – NEW WORK
M3.01 – GROUND FLOOR PLAN – HVAC PIPING – NEW WORK
M3.02 – FIRST FLOOR PLAN – HVAC PIPING – NEW WORK
M4.01 – PART MECHANICAL ROOM PLAN – MECHANICAL – NEW WORK
M5.01 – MECHANICAL SECTIONS
M6.01 – AUTOMATIC TEMPERATURE CONTROLS AND SCHEMATICS
M7.01 – MECHANICAL DETAILS
M8.01 – MECHANICAL SCHEDULES

PLUMBING

P2.01 – FIRST FLOOR PLAN – PLUMBING – NEW WORK

ELECTRICAL

E0.01 – ELECTRICAL LEGEND, ABBREVIATIONS AND GENERAL NOTES

E0.02 – LIGHTING FIXTURE SCHEDULE, SEQUENCE OF OPERATIONS AND
LEGEND

E1.01 – BASE FLOOR PLAN – ELECTRICAL

E1.02 – GROUND FLOOR PLAN – ELECTRICAL – DEMOLITION

E1.03 – FIRST FLOOR PLAN – ELECTRICAL – DEMOLITION

E1.04 – SECOND FLOOR PLAN – ELECTRICAL

E2.01 – FIRST FLOOR PLAN – POWER AND SPECIAL SYSTEMS – NEW WORK

E3.01 – FIRST FLOOR PLAN – LIGHTING – NEW WORK

E4.01 – MECHANICAL ROOM PART PLANS – POWER – DEMOLITION AND NEW
WORK

E5.01 – ELECTRICAL DETAILS

E5.02 – ELECTRICAL DETAILS

E6.01 – ELECTRICAL PANEL SCHEDULES

END OF LIST OF DRAWINGS

SECTION 237313 – INDOOR AIR HANDLING UNITS

PART 1 - GENERAL

1.1 SUMMARY

- A. Scope: Extent of air handling unit work required by this Section is indicated on the drawings, by requirements of this Section, and all other Division-23 Sections.
- B. Refer to requirements of Division-26.

1.2 QUALITY ASSURANCE

- A. Manufacturer's Qualifications: Provide air handling units that are the standard product of an equipment manufacturer regularly engaged in the production of such units who issues complete catalog information on such products. Units shall not be fabricated by the Contractor.
- B. Certifications: Provide certified ratings of units based on tests performed in accordance with ARI 430.
- C. Codes and Standards: Provide air handling units conforming to the following:
 - 1. Air Movement and Control Association, Inc. (AMCA): Comply with applicable AMCA including:
 - a. 210 Laboratory Methods of Testing Fans for Rating Purposes
 - b. 500 Test Method for Louvers, Dampers, and Shutters
 - 2. Air-Conditioning and Refrigeration Institute (ARI): Comply with applicable ARI including the following:
 - a. 410 Forced-Circulation Air-Cooling and Air-Heating Coils
 - b. 430 Central-Station Air-Handling Units
 - 3. American Society of Heating, Refrigerating and Air-Conditioning Engineers (ASHRAE): Construct and install refrigerant coils in accordance with ASHRAE 15, "Safety Code for Mechanical Refrigeration."
 - 4. National Electrical Manufacturers Association (NEMA): Except for motors, provide electrical components required as part of air handling units, which comply with NEMA Standards.
 - 5. National Fire Protection Association (NFPA): Provide air handling unit internal insulation having flame spread rating not over 25 and smoke developed rating no higher than 50; and complying with NFPA 90A, "Standard for the Installation of Air Conditioning and Ventilating Systems." Comply with NFPA 70, "National Electrical Code," as applicable for installation and electrical connections of ancillary electrical components of air handling units.

6. Sheet Metal and Air Conditioning Contractors' National Association, Inc. (SMACNA): Comply with applicable SMACNA standards including "HVAC Duct Construction Standards - Metal and Flexible."
7. Underwriters Laboratories, Inc. (UL): Except for motors, provide electrical components required as part of air handling units, which have been listed and labeled by UL.

1.3 SUBMITTALS

- A. Product Data: Submit manufacturer's technical product data for air handling units showing dimensions, weights, capacities, ratings, fan performance with operating point clearly indicated, motor electrical characteristics, and finishes of materials, and installation instructions.
- B. Shop Drawings: Submit shop drawings showing unit dimensions, weight loadings, required clearances, field connection details and methods of support. Draw to a scale of one half inch to one foot (13 mm to 300 mm), using same sheet size as Contract Drawings. Include field fabricated mixing boxes, dampers and duct connections.
- C. Maintenance Data: Submit maintenance instructions, including instructions for lubrication, filter replacement, motor and drive replacement, and spare parts lists. Include this data, product data, shop drawings, and wiring diagrams in operating and maintenance manuals.

1.4 DELIVERY, STORAGE AND HANDLING

- A. Delivery: Deliver air handling units with factory-installed shipping skids and lifting lugs; pack small components in factory-fabricated protective containers.
- B. Handling: Handle air handling units carefully to avoid damage to components, enclosures, and finish. Do not install damaged components; replace and return damaged components to air handling unit manufacturer.
- C. Storage: Store air handling units in clean dry place and protect from weather and construction traffic.
- D. Unloading: Comply with manufacturer's rigging and installation instructions for unloading air handling units, and moving them to final locations.

PART 2 - PRODUCTS

2.1 MANUFACTURERS

- A. Available Manufacturers: Subject to compliance with requirements, manufacturers offering products which may be incorporated in the work, shall be limited to the following:
 1. Daikin
 2. Trane

3. York
4. Carrier

2.2 INDOOR AIR HANDLING UNITS

A. General:

1. Unit may consist of a fan section, chilled water cooling coil section, heating coil section, filter section, access section and mixing box or combination filter mixing box, as indicated on the drawings.
2. All units shall be supplied with a longitudinal structural steel perimeter base rail that shall serve as a housekeeping rail when unit is installed. Base rail shall be installed by the manufacturer at the factory. Perimeter lifting lugs for overhead lifting shall be provided. Slinging of units in lieu of lifting lugs is not acceptable.
3. Provide one additional set of replacement filters.
4. Provide magnehelic filter gauges for each filter bank, graduated to read from 0 to 3" W.G. (0 to 75 Pa).
5. At the contractor's discretion, the units may be shipped in component modules.
6. The units shall be disassembled and reassembled; see paragraph 3.02 of this section.

B. Unit Cabinet:

1. Unit panels for each section of unit shall be 2-inch (50 mm) thick, thermal break, double-walled assembly, foam injected insulation with an R-value of not less than R-13. Outer panel shall be constructed of 20 gauge (1.3 mm) painted, galvanized steel. Inner panel shall be constructed of 22 gauge (1 mm) G90 galvanized steel. Entire floor shall also be double-walled with the same liner as the side and roof panels.
2. Panel deflection shall not exceed L/240 ratio at 125% of design static pressure, maximum 5 inches of positive or 6 inches of negative static pressure. Deflection shall be measured at the panel midpoint.
3. Hinged access doors shall be full height insulated double-wall with heavy duty stainless steel hinges and chromed plated dogged fasteners to provide air-tight compression of the perimeter gasket. Doors shall be lift-off type, removable at hinge pin to provide maximum service access.

C. Fan Section:

1. The fan array will be arranged with high performance direct drive, single inlet, plenum fans with backwards inclined, high efficiency welded-aluminum or high-performance composite impeller with galvanized or aluminum support frame.

2. The fans are driven by long-life, low-temperature brushless DC electronically commutated motor (EC-Motor) with external rotor and integrated maintenance-free electronic circuitry and electronics. The motor is manufactured with maintenance-free, permanently lubricated ball bearings and shall be statically and dynamically balanced in accordance with ISO 1940 part 1. The motor shall be closed, protection level IP 54, thermal class 155 with permissible operating temperature of -13°F to 140°F. Motor efficiency class shall comply with IE4. Fan characteristic curves indicate measurements on a chamber test in accordance with ISO5801. The three-phase external rotor motor integrated into the fan hub meets the requirements for circulating electric machines set forth in DIN EN 60 034-1 (VDE 0530 Part 1).
3. Manual blank-off plates shall be provided to block fan airflow, one plate to be provided per array.
4. Fan Array shall be listed per UL 1995.
5. Fan assemblies shall be prewired with wire whips and plug connectors.
6. Fan system manufacturer must stock replacement parts in North America.
7. The fan bulkhead wall shall be constructed in a manner for easy field assembly, constructed of 14 gauge G90 formed sheet metal. The bend profile at each panel's seam shall provide vertical structural support for the bulkhead wall.
8. The control panel shall include an external disconnect and shall be UL or ETL listed. Each panel contains a lockable Hand/Off/Auto switch for optional manual speed control. The panel accepts a 0-10VDC signal when in Auto mode, and can be controlled locally when in Hand Mode.
9. There is a system alarm contact that the BAS can use to check the status of the Q-PAC System. There is a system enable contact that the BAS can use to enable or disable the Q-PAC System, along with a safety circuit terminations.
10. All Q-PAC components shall be sized to fit through a 20" x 40" access opening.

D. Coil Sections:

1. All coil sections shall be constructed of insulated mill galvanized steel panels. All coils must be easily removable from top or side of horizontal units and from the side of vertical units. Condensate drain pan shall be insulated double-wall stainless steel, sloped in two (2) directions toward drain fitting with a recessed vertical exit non-trapping design with integral elbow for side discharge and female pipe thread connection. A maximum of one drain shall be supplied for each cooling coil sections. Unless this drain pan is continuous between the fan and coil sections, the fan section shall not be allowed to have a drain. Moisture shall not carry over to the fan. Moisture eliminators downstream of cooling coils are not acceptable. Cooling unit shall be sized to ensure against moisture carry over without

the use of moisture eliminators.

2. All coils shall be tested at 325 psig (2210 kPa) air pressure while submerged in water. Coil performance shall be certified in accordance with ARI Standard 410. All coils shall have mill galvanized steel casings.
3. Chilled water coils shall be aluminum plate fins with belled collars and bonded to 1/2 inch (13 mm) OD copper tubes by mechanical expansion. Coils shall have steel or non-ferrous headers with MPT connections. Working pressure shall be 250 psig (1700 kPa) at 300°F (150°C). Coils shall be drainable and have non-trapping circuits. Headers shall have drain and vent connections. Vents and drains that are installed in coil return or supply bends promote coil tube fatigue and shall not be allowed.
4. Hot water coils shall be aluminum plate fins with belled collars bonded to 1/2 inch (13 mm) OD copper tubes by mechanical expansion. Coils shall have steel headers with MPT connections. Working pressures shall be 250 psig (1700 kPa) at 300°F (150°C). Headers shall have drain and vent connections.
5. Tube wall thicknesses shall not be less than 0.020 inches (.5 mm) and tube diameter on all coils shall not be less than 1/2 inch (13 mm) OD.
6. Chilled water coil face velocities shall not exceed 500 fpm (2.5 m/g) except where indicated on drawings.
7. Coil turbulators will not be acceptable.

E. Mixing Box Sections:

1. Each mixing box section where applicable, shall be designed and constructed to house the specific type of filter shown on the equipment schedule. A double-walled hinged access door shall be provided on the side of the section.
2. Mixing boxes shall have parallel blade, interconnecting outside air and return air dampers. All mixing boxes shall have a double-walled hinged access door.
3. All damper blades shall be double skin galvanized steel airfoil, mechanically fastened to a 1/2 inch (13 mm) diameter steel rod rotating in stainless steel bearing. (Dampers shall be sectionalized to limit blade length to no more than 48 inches (1200 mm) so as to minimize blade warpage and to assure tight closure.)
4. Return damper shall be rated for a maximum leakage rate per square foot of 4 cfm (2 L/s) @ 1" wc (250 Pa) and 9 cfm (4.2 L/s) @ 4" wc (1000 Pa). Provide ultra-low leak type for outside air damper.

F. Filters:

1. Rigid filter frames shall be welded galvanized steel, constructed as an integral part of the unit. Filter frames shall be galvanized steel and provide

positive seals around the filters.

2. Pre-filters shall be 2-inch (50 mm) thick non-woven cotton fabric, treated with adhesive and continuously laminated to a supported steel wire grid. Filters shall be 30% ASHRAE 52.1-1992 efficient with a minimum MERV of 8.
3. Cartridge filters shall be constructed by pleating a continuous sheet of fine-fiber media into closely spaced pleats with safe-edged aluminum separators. The filter shall be sealed into a metal frame assembled in a rigid manner. All cartridge filters to be furnished with a pre-filter to provide extended cartridge life. Manufacturer shall supply side access filter rack capable of holding cartridge filters and 2-inch (50 mm) pre-filters. Cartridge filters shall be 80–85% ASHRAE 52.1-1992 efficient with a minimum MERV of 13.
4. Filter sections shall have double walled hinged access doors.
5. Magnehelic gauges shall be provide for each filter bank.

G. Access and Plenum Sections:

1. Access and plenum sections shall be installed where indicated on the drawings.
2. Access sections shall have a double-walled hinged door.

2.3 MOTORS

- A. See Division-23 Section, “Electrical Provisions for HVAC Equipment” for minimum motor efficiencies and other requirements.

PART 3 - EXECUTION

3.1 INSTALLATION OF AIR HANDLING UNITS

- A. General: Install air handling units where indicated on the drawings, in accordance with equipment manufacturer's published installation instructions.
- B. Access: Provide access space around air handling units for service as indicated on the drawings, but in no case less than that recommended by the manufacturer.
- C. Mounting: Mount air handling units with internal factory furnished isolators in accordance with manufacturer's instructions.
- D. Electrical Wiring: Install electrical devices furnished by manufacturer but not specified to be factory-mounted.
1. Verify that electrical wiring installation is in accordance with manufacturer's submittal and installation requirements of Division-26 sections.
- E. Piping Connections: Provide piping, valves, accessories, gauges, supports, and

flexible connections as indicated on the drawings. Locate freeze stats and trap air handling unit drain-pan connections according to manufacturer's recommendations.

- F. Duct Connections: Provide ductwork, accessories, and flexible connections as required.
- G. Extend condensate drain to nearest drain. Provide trap at drain pan at least 1" (25 mm) deeper than total supply fan pressure in inches of water column. For indoor units, provide a concrete pad of adequate height to allow for proper installation of condensate drain trap above floor.
- H. Provide MERV 13 filter media at all return air inlet locations throughout the duration of construction. Filter media shall not be removed until final filters are installed in the air handling units.

3.2 AIR HANDLING UNIT DISASSEMBLY AND REASSEMBLY

- A. Where required, the air handling units shall be disassembled by the mechanical contractor, transported with rigging as required to the assigned mechanical rooms located at the building interior, and reassembled in their permanent location. The air handling unit panels, doors, coils, fan base, superstructure, etc, shall be 100% bolted construction to facilitate the disassembly and reassembly procedure. Welded construction shall not be permitted. The manufacturer shall include costs for factory authorized representative(s) to supervise the complete disassembly and reassembly of the air handling units.
- B. Upon reassembly of the units, the unit manufacturer representative(s) shall inspect the installation and certify that the unit meets the manufacturer's standards. The inspection/certification shall include, but not be limited to, the following:
 - 1. Pulley alignment and adjustment.
 - 2. Superstructure inspection verifying all panels and unit frame are installed to manufacturer's standards.
 - 3. Spring isolator adjustment and certification.
 - 4. Motor operated damper adjustment and operation verification.
 - 5. Fan motor amperage reading with the fan operating at 60Hz.
 - 6. Belt tension reading and adjustment.
 - 7. Drain pan inspection.
 - 8. Access door operation and adjustment.
 - 9. Filter inspection.
 - 10. Pressure test(s) of the entire unit shall be performed and the maximum allowable leakage shall be one percent (1%) at 125% times the unit operating pressure, but not less than six inches (6") w.c.

- C. The owner shall be invited to be present during all testing and inspections and shall be given a minimum of one week notice (5 business days) prior to testing and certification.
- D. Upon completion of the inspection and testing, the manufacturer shall provide the installing contractor and the owner a type written report indicating deficiencies found. The deficiencies shall then be corrected to the satisfaction of the manufacturer and the owner.
- E. Upon completion of the inspection, testing, certification and start-up, the manufacturer shall provide the owner with a signed letter indicating that all warranties, either implied or expressed, shall remain in effect for a period of two years from the date of final approval by the manufacturer and the owner. The letter shall include the unit serial number, model number, as well as the location and address of the installed units.

3.3 FUNCTIONAL PERFORMANCE TESTING AND VERIFICATION

- A. General: In addition to the tests required during and after installation of all mechanical systems, as well as any other formal commissioning requirements, the unit manufacturer shall perform functional performance tests to verify that all systems are designed, installed, calibrated and adjusted to perform as required in the Contract.
- B. Comply with all applicable specification sections including, but not be limited to, "Basic HVAC Requirements", "Testing, Adjusting and Balancing", "Automatic Temperature Controls" and "Commissioning", where applicable.
- C. Prior to functional performance testing, all indicating, recording and control devices shall be calibrated. A verification calibration report shall be provided with the final test report.
- D. Provide functional performance testing to verify proper operation of each control sequence associated with the unit indicated throughout the contract documents.
- E. Failure of Tests: Should any test, verification, or demonstration fail to meet the specification requirements, the component of the system causing the failure shall be repaired, replaced or readjusted. The failed test, verification, or demonstration shall then be repeated.
- F. A "Functional Performance Test Verification Form" is included at the end of Section 230900. This form (electronic version is available upon request) shall be completed for each air handling unit provided under this contract.
- G. Test Report: Upon satisfactory verification of calibration and functional performance tests, a copy of the final test results shall be bound in the operations and maintenance manual. The final report shall also include a full compliance statement, on company letterhead, indicating that all units are installed and functioning per the contract requirements including drawings, specifications, control sequences and accepted submittals.
- H. The air handling unit installation shall not be considered complete until all functional performance verification forms, calibration reports and compliance

statement have been submitted and reviewed. Submit in accordance with the submittal requirements indicated elsewhere in these specifications.

3.4 EXTRA STOCK

- A. Filters: Furnish one (1) extra set of filters for each air handling unit to the owner. In addition, install new filters at completion of air handling system work, and prior to testing, adjusting, and balancing work. Do not operate fans unless filters are in place.

END OF SECTION 237323




MACKLIN TOWER

MBI FINANCE LAB SUITE 100

Rockville Campus
Building No. 206



QUINN EVANS
ARCHITECT

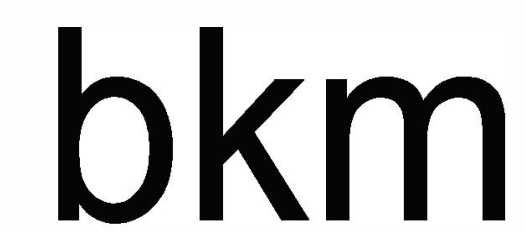

BURDETTE, KOEHLER, MURPHY & ASSOCIATES, INC.
MECHANICAL/ ELECTRICAL/ PLUMBING ENGINEERS

A+F ENGINEERS
STRUCTURAL ENGINEERS

BKM PROJECT NO. 19106.01
100% CONSTRUCTION DOCUMENTS
MARCH 06, 2020

DRAWING INDEX			
DWG. No.	DESCRIPTION	DWG. No.	DESCRIPTION
CS	COVER SHEET	M0.01	MECHANICAL LEGEND ABBREVIATIONS & GENERAL NOTES
Q0.11	LIFE SAFETY PLANS	M1.01	GROUND FLOOR PLAN - MECHANICAL - DEMOLITION
STRUCTURAL DRAWINGS		M1.02	FIRST FLOOR PLAN - MECHANICAL - DEMOLITION
S0.01	STRUCTURAL GENERAL NOTES & SPECIAL INSPECTIONS SCHEDULE	M2.01	GROUND FLOOR PLAN - DUCTWORK - NEW WORK
S1.01	STRUCTURAL PLAN & ELEVATIONS	M2.02	FIRST FLOOR PLAN - DUCTWORK - NEW WORK
S2.01	STRUCTURAL SECTIONS & DETAILS	M3.01	GROUND FLOOR PLAN - HVAC PIPING - NEW WORK
S2.02	STRUCTURAL SECTIONS & DETAILS	M3.02	FIRST FLOOR PLAN - HVAC PIPING - NEW WORK
ARCHITECTURAL DRAWINGS		M4.01	PART GROUND FLOOR PLAN - MECHANICAL - DEMOLITION & NEW WORK
A0.01	LEGENDS, SYMBOLS, ABBREVIATIONS	M5.01	MECHANICAL SECTIONS
A0.12	PARTITION TYPES	M6.01	HVAC PIPING DIAGRAMS - DEMOLITION
AD1.01	DEMOLITION PLAN - GROUND FLOOR	M6.02	HVAC PIPING DIAGRAMS - NEW WORK
AD1.02	DEMOLITION PLAN - FIRST FLOOR	M6.03	HVAC PIPING DIAGRAMS - NEW WORK - ALTERNATE
AD1.11	DEMOLITION RCP - GROUND FLOOR	M7.01	AUTOMATIC TEMPERATURE CONTROLS
AD1.12	DEMOLITION RCP - FIRST FLOOR	M8.01	MECHANICAL DETAILS
A1.01	GROUND FLOOR PLAN	M9.01	MECHANICAL SCHEDULES
A1.02	FIRST FLOOR PLAN	PLUMBING DRAWINGS	
A1.12	FIRST FLOOR PLAN RCP	P2.01	FIRST FLOOR PLAN - PLUMBING - NEW WORK
A4.01	ENLARGED PLANS & ELEVATIONS	ELECTRICAL DRAWINGS	
A6.01	DOOR SCHEDULES	E0.01	ELECTRICAL LEGEND, ABBREVIATIONS & GENERAL NOTES
A6.02	FINISH PLAN & SCHEDULE	E0.02	LIGHTING FIXTURE SCHEDULE, SEQUENCE OF OPERATIONS & LEGEND
A6.07	FINISH SCHEDULE & DETAILS	E1.01	BASEMENT FLOOR PLAN - ELECTRICAL
A6.21	SIGNAGE TYPES & DETAILS - SYSTEM OVERVIEW & TYPICAL REQUIREMENTS	E1.02	FIRST FLOOR PLAN - ELECTRICAL - DEMOLITION
		E1.03	FIRST FLOOR PLAN - ELECTRICAL - DEMOLITION
		E1.04	SECOND FLOOR PLAN - ELECTRICAL
		E2.01	FIRST FLOOR PLAN - POWER AND SPECIAL SYSTEMS - NEW WORK
		E3.01	FIRST FLOOR PLAN - LIGHTING - NEW WORK
		E4.01	MECHANICAL ROOM PART PLANS - POWER - DEMOLITION AND NEW WORK
		E5.01	ELECTRICAL DETAILS
		E5.02	ELECTRICAL DETAILS
		E6.01	ELECTRICAL PANEL SCHEDULES

PROJECT ALTERNATES

ADD ALTERNATE - PROVIDE HVAC PIPING MODIFICATION TO AIR HANDLING UNIT EQUIPMENT SERVING LIBRARY.

CODE SUMMARY

THE DESIGN AND CONSTRUCTION OF ALL STRUCTURES SHALL BE IN COMPLIANCE WITH THE LATEST ADOPTED EDITION OF CHAPTER 5 BUILDINGS AND BUILDING REGULATIONS (AMENDED EFFECTIVE 2020) OF THE ROCKVILLE CITY CODE, THE MARYLAND BUILDING PERFORMANCE STANDARDS (AMENDED EFFECTIVE JANUARY 1, 2020) AND THE MARYLAND STATE FIRE PREVENTION CODE (AMENDED EFFECTIVE JANUARY 1, 2020).

- THE CITY OF ROCKVILLE INSPECTION SERVICES DIVISION ALSO ENFORCES THE FOLLOWING APPLICABLE CODES AND STANDARDS WITH AMENDMENTS:
 - 2016 NFPA 13, 130, 135 SPRINKLER CODE
 - 2016 NFPA 72 ALARM AND SIGNALING CODE
 - 2018 NFPA 1 FIRE CODE
 - 2018 NFPA 101 LIFE SAFETY CODE
 - 2017 NFPA 70 NATIONAL ELECTRIC CODE (NEC)
 - 2018 NFPA 80A DUCT DETECTORS SMOKE DETECTION
 - 2015 INTERNATIONAL GREEN CONSTRUCTION CODE
 - 2018 INTERNATIONAL BUILDING CODE (IBC)
 - 2018 INTERNATIONAL PLUMBING CODE (IPC)
 - 2018 INTERNATIONAL MECHANICAL CODE (IMC)
 - 2018 INTERNATIONAL FUEL GAS CODE (IFGC)
 - 2018 INTERNATIONAL ENERGY CONSERVATION CODE (IECC)
 - 2018 INTERNATIONAL EXISTING BUILDING CODE (IEBC)
 - 2017 NATIONAL ELECTRICAL CODE (NFPA 70)
 - 2018 STATE OF MARYLAND FIRE PREVENTION CODE
 - CITY OF ROCKVILLE AMENDMENTS

- BUILDING INFORMATION:
 - HEIGHT: 70 FT FROM THE GRADE PLANE TO THE HEIGHT OF THE HIGHEST ROOF SURFACE
 - THE BUILDING HEIGHT, AREA AND CONSTRUCTION TYPE WILL NOT BE MODIFIED AS A RESULT OF THE RENOVATIONS.
 - HEIGHT AND AREA REQUIREMENTS DO NOT NEED TO BE MET BASED ON THE EXTENT OF THE RENOVATION PER THE IEBC
 - NUMBER OF STORES: 8 STORES TOTAL
 - BUILDING AREA: 114,820 SQUARE FEET
 - FLOOR AREA UNDER CONSTRUCTION: 7,575 SQUARE FEET
 - CONSTRUCTION CLASSIFICATION: EXISTING TYPE IIB
 - OCCUPANCY CLASSIFICATION: BUSINESS USE GROUP B
- EXIT ACCESS TRAVEL DISTANCE: BUSINESS (NFPA 101 TABLE A.7.6): 300 FEET
- COMMON PATH OF TRAVEL: BUSINESS (NFPA 101 TABLE A.7.6): 100 FEET
- DEAD END CORRIDORS: BUSINESS (NFPA 101 TABLE A.7.6): 50 FEET
- NUMBER OF EXITS (NFPA 101 SECTION 7.4): OCCUPANT LOAD LESS THAN 50, MINIMUM OF TWO EXITS
- EXIT REMOTENESS, FOR SPRINKLERED BUILDING (NFPA 101 SECTION 7.5.1.3): EXIT DOORS/EXIT ACCESS DOORS NOT LESS THAN 1/3 THE MAXIMUM OVERALL DIAGONAL DIMENSION OF AREA SERVED
- EXIT DISCHARGE: NOT MORE THAN 50% OF THE REQUIRED NUMBER OF EXITS, AND NOT MORE THAN 50% OF THE REQUIRED EGRESS CAPACITY, SHALL DISCHARGE THROUGH AREAS ON THE LEVEL OF EXIT DISCHARGE (NFPA 101, SECTION 7.7.2, IBC SECTION 1027.1)
- MINIMUM WIDTH OF EGRESS COMPONENTS:
 - DOORS (NFPA 101 SECTION 7.2.1.2.3.2): 32 INCHES
 - STAIRS (NFPA 101 TABLES 7.2.2.1.1 B AND A): 44 INCHES
 - CORRIDORS: BUSINESS (NFPA 101 SECTIONS 38.2.3 AND 12.2.3.8): 36 INCHES (LESS THAN 50 OCCUPANTS); 44 INCHES (50 OR MORE OCCUPANTS);
 - STORAGE (NFPA 101 SECTION 7.3.4): 36 INCHES
- OCCUPANT LOAD FACTORS (NFPA 101, TABLE 7.3.1.2):

FUNCTION OF SPACE	FLOOR AREA IN SF / OCCUPANT	OCCUPANCY ABBREVIATION
BUSINESS	150 GROSS	BUS
ASSEMBLY - LESS CONCENTRATED	15 NET	A-15
CLASSROOM	20 NET	CLS

- EGRESS CAPACITY FACTORS (NFPA 101, TABLE 7.3.3.1):
 - 0.3 INCHES PER PERSON FOR STAIRS
 - 0.2 INCHES PER PERSON FOR LEVEL EGRESS COMPONENTS
- CALCULATED OCCUPANT LOAD PER FLOOR:

FLOOR LEVEL	OCCUPANT LOAD	AVAILABLE EGRESS
GROUND FLOOR	149	960
FIRST FLOOR	967	2,220
SECOND-SIXTH FLOOR	EXIST UNCHANGED	

- FIRE-RESISTANCE RATINGS FOR TYPE IIB CONSTRUCTION: (IBC TABLE 601):

BUILDING ELEMENT	TYPE IIB
PRIMARY STRUCTURAL FRAME	0
EXTERIOR BEARING WALLS	0
INTERIOR BEARING WALLS	0
INTERIOR NONBEARING WALLS AND PARTITIONS	0
FLOOR CONSTRUCTION AND ASSOCIATED SECONDARY MEMBERS	0
ROOF CONSTRUCTION AND ASSOCIATED SECONDARY MEMBERS	0

- EXIT ACCESS CORRIDORS: CORRIDORS IN FULLY SPRINKLERED GROUP A AND B OCCUPANCIES ARE NOT REQUIRED TO BE FIRE RESISTANT PER IBC TABLE 1020.1
- VERTICAL OPENINGS: SHAFT ENCLOSURES FIRE RESISTANCE RATINGS (IBC SECTION 713.4): NOT LESS THAN 1 HOUR WHERE CONNECTING LESS THAN FOUR STORIES

- FIRE PROTECTION SYSTEMS: THE EXISTING BUILDING IS PARTIALLY PROTECTED BY AN AUTOMATIC SPRINKLER SYSTEM IN ACCORDANCE WITH NFPA 13. THE AREA OF ANY ALTERATIONS WILL BE REQUIRED TO INCLUDE AN AUTOMATIC SPRINKLER SYSTEM TO COMPLY WITH THE REQUIREMENTS OF NFPA 13. THE BUILDING HAS AN EXISTING FIRE ALARM SYSTEM. THERE ARE NO REQUIREMENTS FOR ADDITIONAL FIRE ALARM WORK IN THE AREA OF ALTERATION (IEBC 804.4). THE CURRENT LEVEL SLP NOTIFICATION DEVICES IN THE AREA OF ALTERATION SHOULD BE MAINTAINED IN COMPLIANCE WITH NFPA 72 AND IBC 907.2. THE BUILDING HAS AN EXISTING FIRE ALARM SYSTEM MANUFACTURED BY SIMPLEX MODEL 4100 ES. AUDIBLE AND VISUAL DEVICES WILL BE RELOCATED AND ADDED TO PROVIDE ADEQUATE COVERAGE TO ACCOMMODATE THE WALL MOUNTED, DUCT SMOKE DETECTORS WILL BE PROVIDED FOR THE AIR HANDLING UNIT AND ALSO TO THE ASSOCIATED DUCT WORK FOR CONTROL OF SMOKE DAMPERS.


- INTERIOR FINISHES: BASED ON BUSINESS GROUP B, MATERIALS FOR THE ENTIRE BUILDING WILL MEET THE FOLLOWING CRITERIA:
 - ROOM WALLS AND CEILINGS: CLASS C; 75 - 200 FLAME SPREAD; 0 - 450 SMOKE-DEVELOPED.
 - EXIT ACCESS CORRIDORS: CLASS B; 26 - 75 FLAME SPREAD; 0 - 450 SMOKE-DEVELOPED.
 - VERTICAL EXITS: CLASS B; 26 - 75 FLAME SPREAD; 0 - 450 SMOKE-DEVELOPED.
 - FLOOR FINISHES IN EXIT ENCLOSURES: CLASS II; RADIANT FLUX NOT LESS THAN 2.2 KW/M² BUT LESS THAN 4.5 KW/M².
 - SEE FINISH SCHEDULE, A602, FOR FLAMESPREAD AND SMOKE DEVELOPMENT INFORMATION FOR INTERIOR WALL AND FLOOR FINISH MATERIALS.

PLUMBING FIXTURE CALCULATIONS - IPC TABLE 403.1


USE CLASSIFICATION = BUSINESS B REQUIRED (TOTAL FIXTURE OCC LOAD FIRST FLOOR = 51, OCC LOAD PER SEX = 26 (51/2))

- WOMEN TOILETS (1 PER 25 FOR 50 + 1 PER 50 REMAINING): 1 WC (2 FOR FIRST 50)
- WOMEN SINKS (1 PER 40 FOR 80 + 1 PER 80 REMAINING): 1 LAV SINKS (1 FOR FIRST 40)
- MEN TOILETS (1 PER 25 FOR 50 + 1 PER 50 REMAINING): 1 WC (1 FOR FIRST 25)
- MEN SINKS (1 PER 40 FOR 80 + 1 PER 80 REMAINING): 1 LAV SINKS (1 FOR FIRST 25)
- DRINKING FOUNTAINS (1 PER 100): 1 TOTAL
- SERVICE SINKS (1 PER FLOOR): 1 TOTAL

- TOTAL PROVIDED:**
- WOMEN TOILETS: 1 WC
 - WOMEN SINKS: 1 LAV SINKS
 - MEN TOILETS: 1 WC
 - MEN SINKS: 1 LAV SINKS
 - DRINKING FOUNTAINS: 1 FOUNTAINS [+ WATER COOLER PER IPC 410.3]
 - SERVICE SINKS: 1 TOTAL

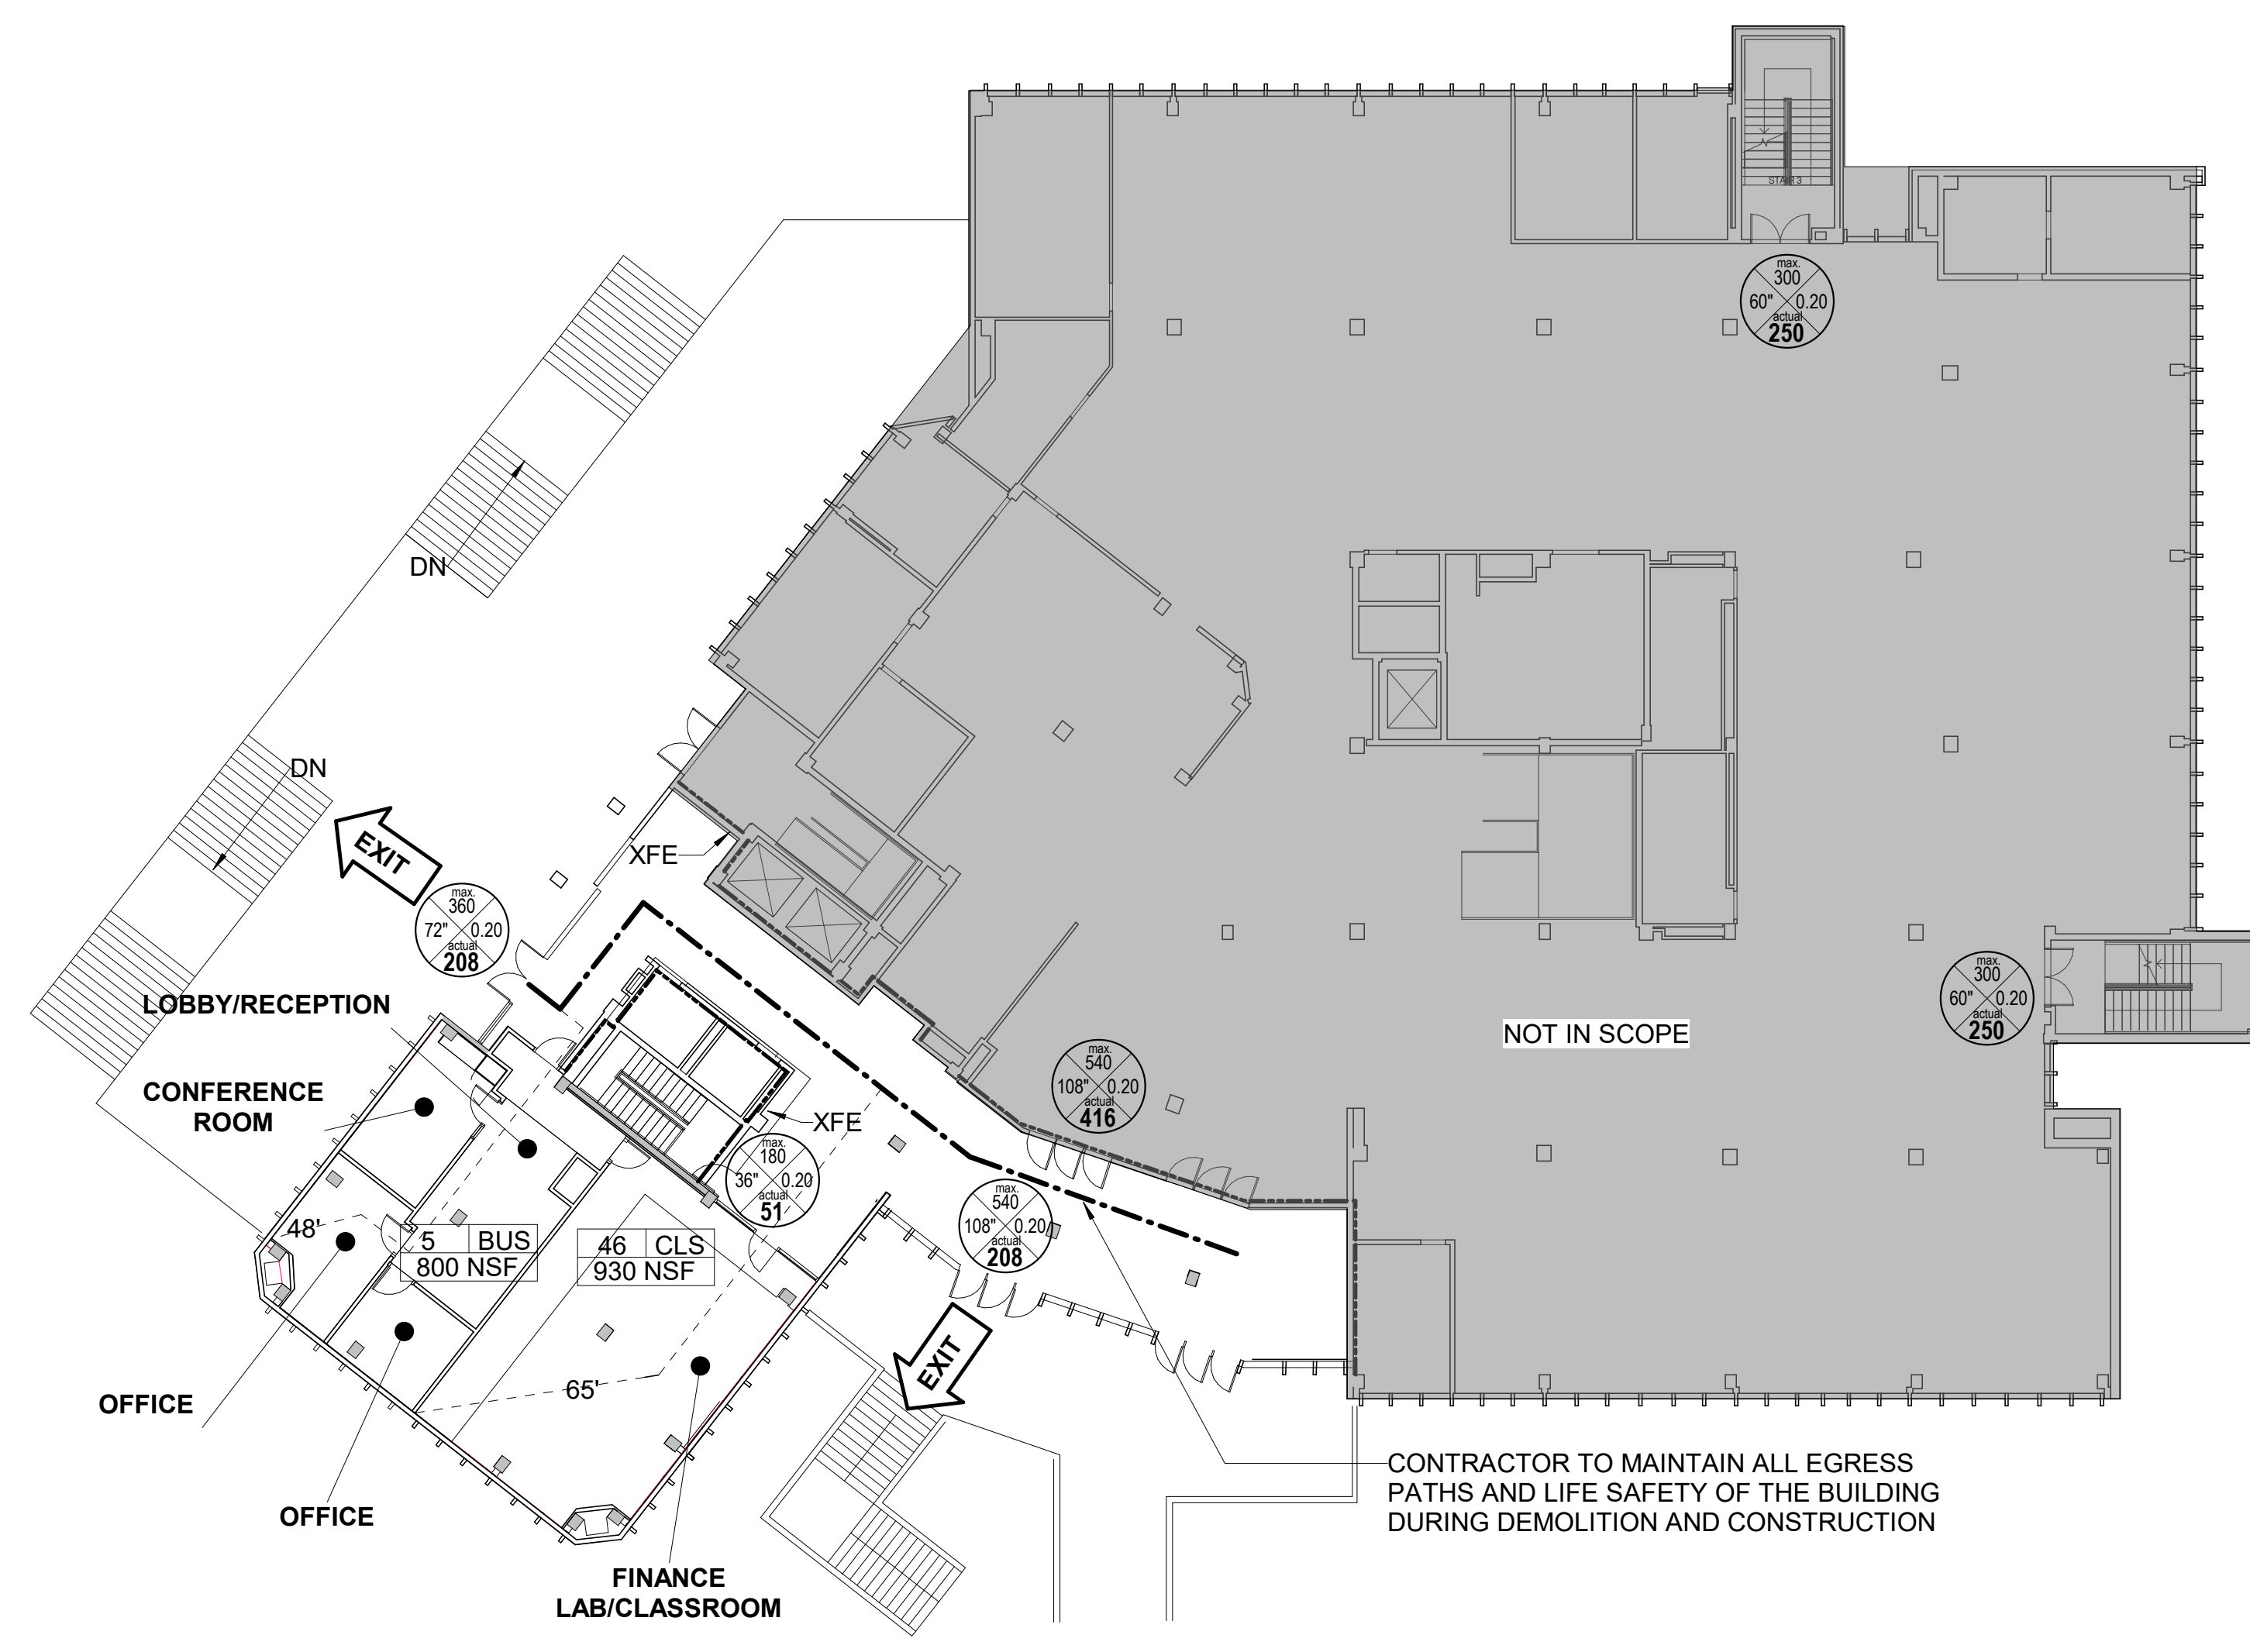

2
G011
1/16" = 1'-0"
FIRST FLOOR LIFE SAFETY

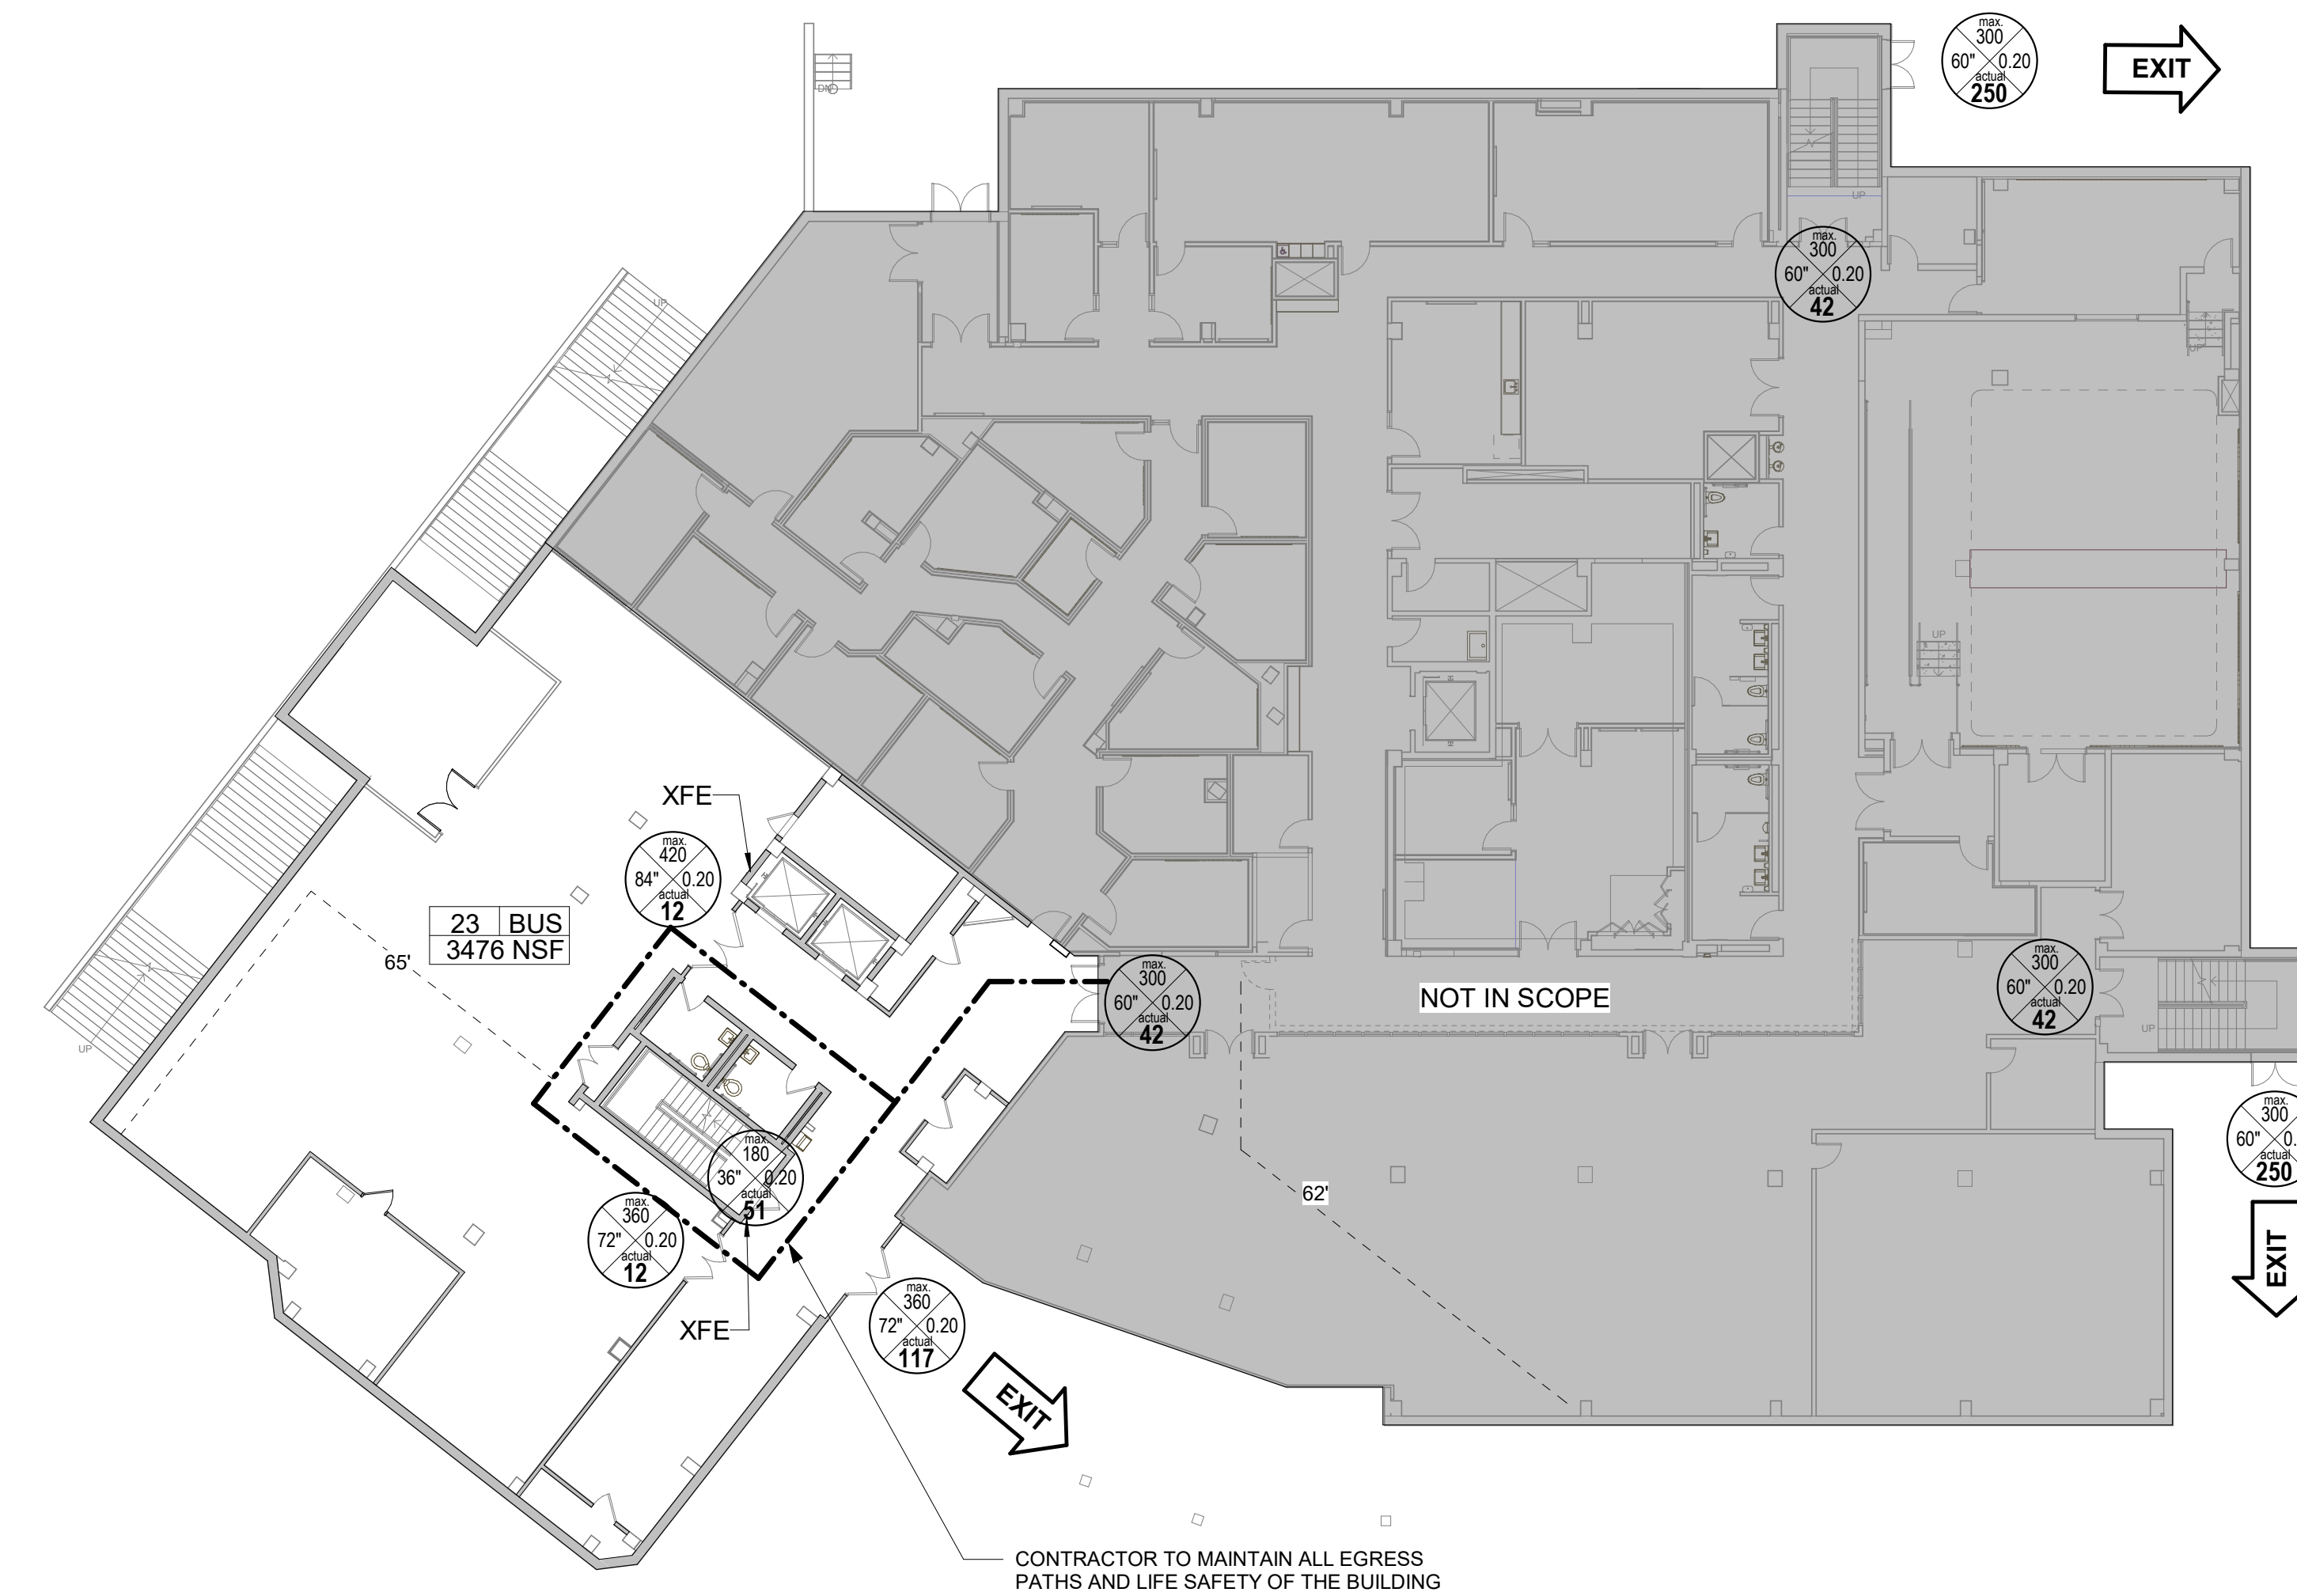


1
G011
1/16" = 1'-0"
GROUND LEVEL LIFE SAFETY

LIFE SAFETY LEGEND:


- Room name: ROOM TAG
- 15,000 SF: ROOM IDENTIFIER
- 43: ROOM AREA
- 43: ROOM OCCUPANT LOAD FACTOR
- 43: NO. OF OCCUPANTS
- 200: STAIR OR DOOR EGRESS TAG
- 0: STAIR OR DOOR IDENTIFIER
- 0: STAIR OR DOOR CLEAR WIDTH
- 0: EXIT CAPACITY FACTOR
- 0: EXIT CAPACITY
- 0: ACTUAL OCCUPANT LOAD
- 1-HOUR BARRIER
- 2-HOUR BARRIER
- Travel Distance: COMMON PATH OF TRAVEL DISTANCE
- EXIT: PATH INTO EXIT
- XFE: EXISTING FIRE EXTINGUISHER
- FE: FIRE EXTINGUISHER

1/16" = 1'-0"
LIFE SAFETY LEGEND - AREAS

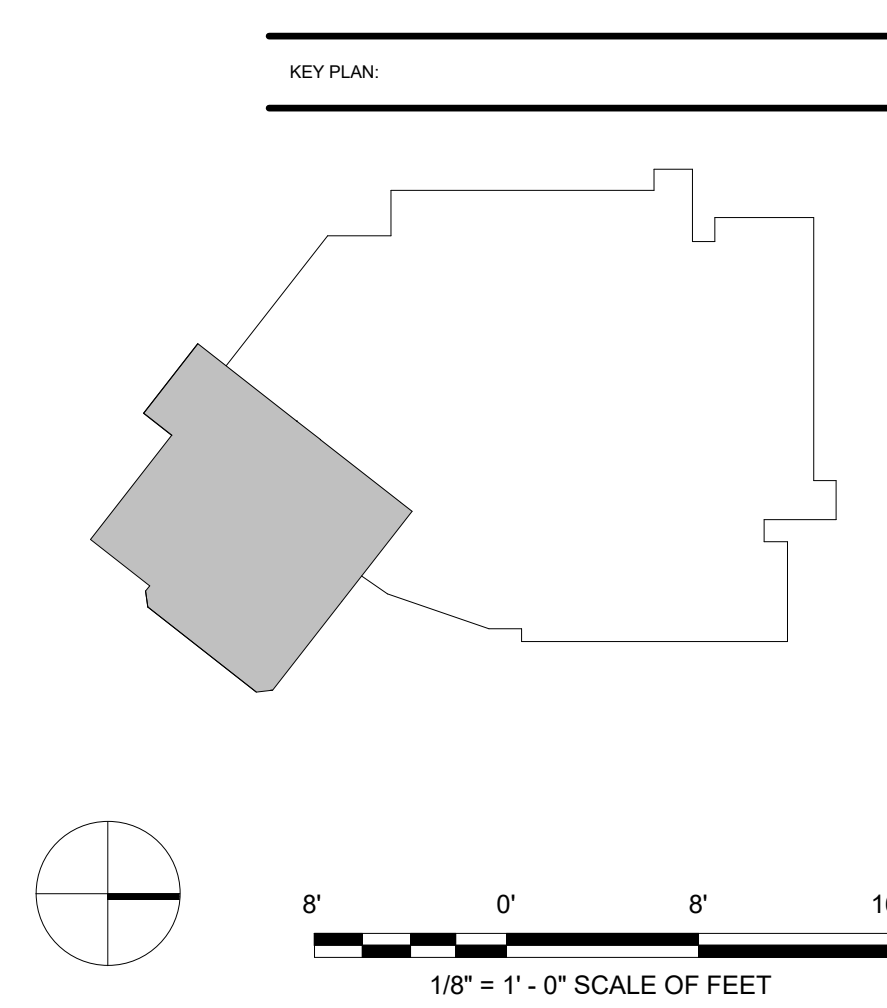

Central Administration
Office of Facilities
9221 Corporate Boulevard
Rockville, MD 20850
Telephone: 240-567-7363

MACKLIN TOWER MBI SUITE RENOVATIONS

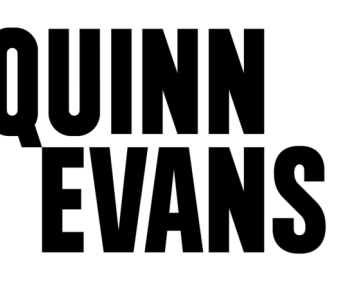

QUINN EVANS ARCHITECTS
100 N. Charles Street | 410.576.0440
14th Floor | Rockville, MD 20850
Baltimore, MD 21201 | www.quinnevans.com

SEAL:

PROFESSIONAL CERTIFICATION: I HEREBY CERTIFY THAT THESE DOCUMENTS WERE PREPARED OR APPROVED BY ME, AND THAT I AM A DULY LICENSED PROFESSIONAL ENGINEER UNDER THE LAWS OF THE STATE OF MARYLAND.
LICENSE NO. 13613
EXPIRATION DATE: 09/08/2021

ISSUED FOR:

DATE:	DESCRIPTION:
3/6/2020	100% CONSTRUCTION DOCUMENTS
3/25/2020	ADDENDUM #1

PROJECT NO: BKM # 19106.01

SCALE: AS NOTED

DRAWN BY: NM

CHECKED BY: BO

DATE: 03/06/2020

SHEET TITLE: LIFE SAFETY PLANS

DRAWING NO:

G011

BKM# 19106.01




**MACKLIN TOWER
 BLDG. 206
 MBI FINANCE LAB
 SUITE 100**

QUINN EVANS ARCHITECTS

Architects
 100 N. Charles Street
 14th Floor
 Baltimore, MD 21201
 410.576.0440
 www.quinnevans.com

A+F ENGINEERS


Structural Engineers
 1112 16TH STREET NW
 #620
 WASHINGTON, DC 20036
 202.628.1800
 www.af-engineers.com

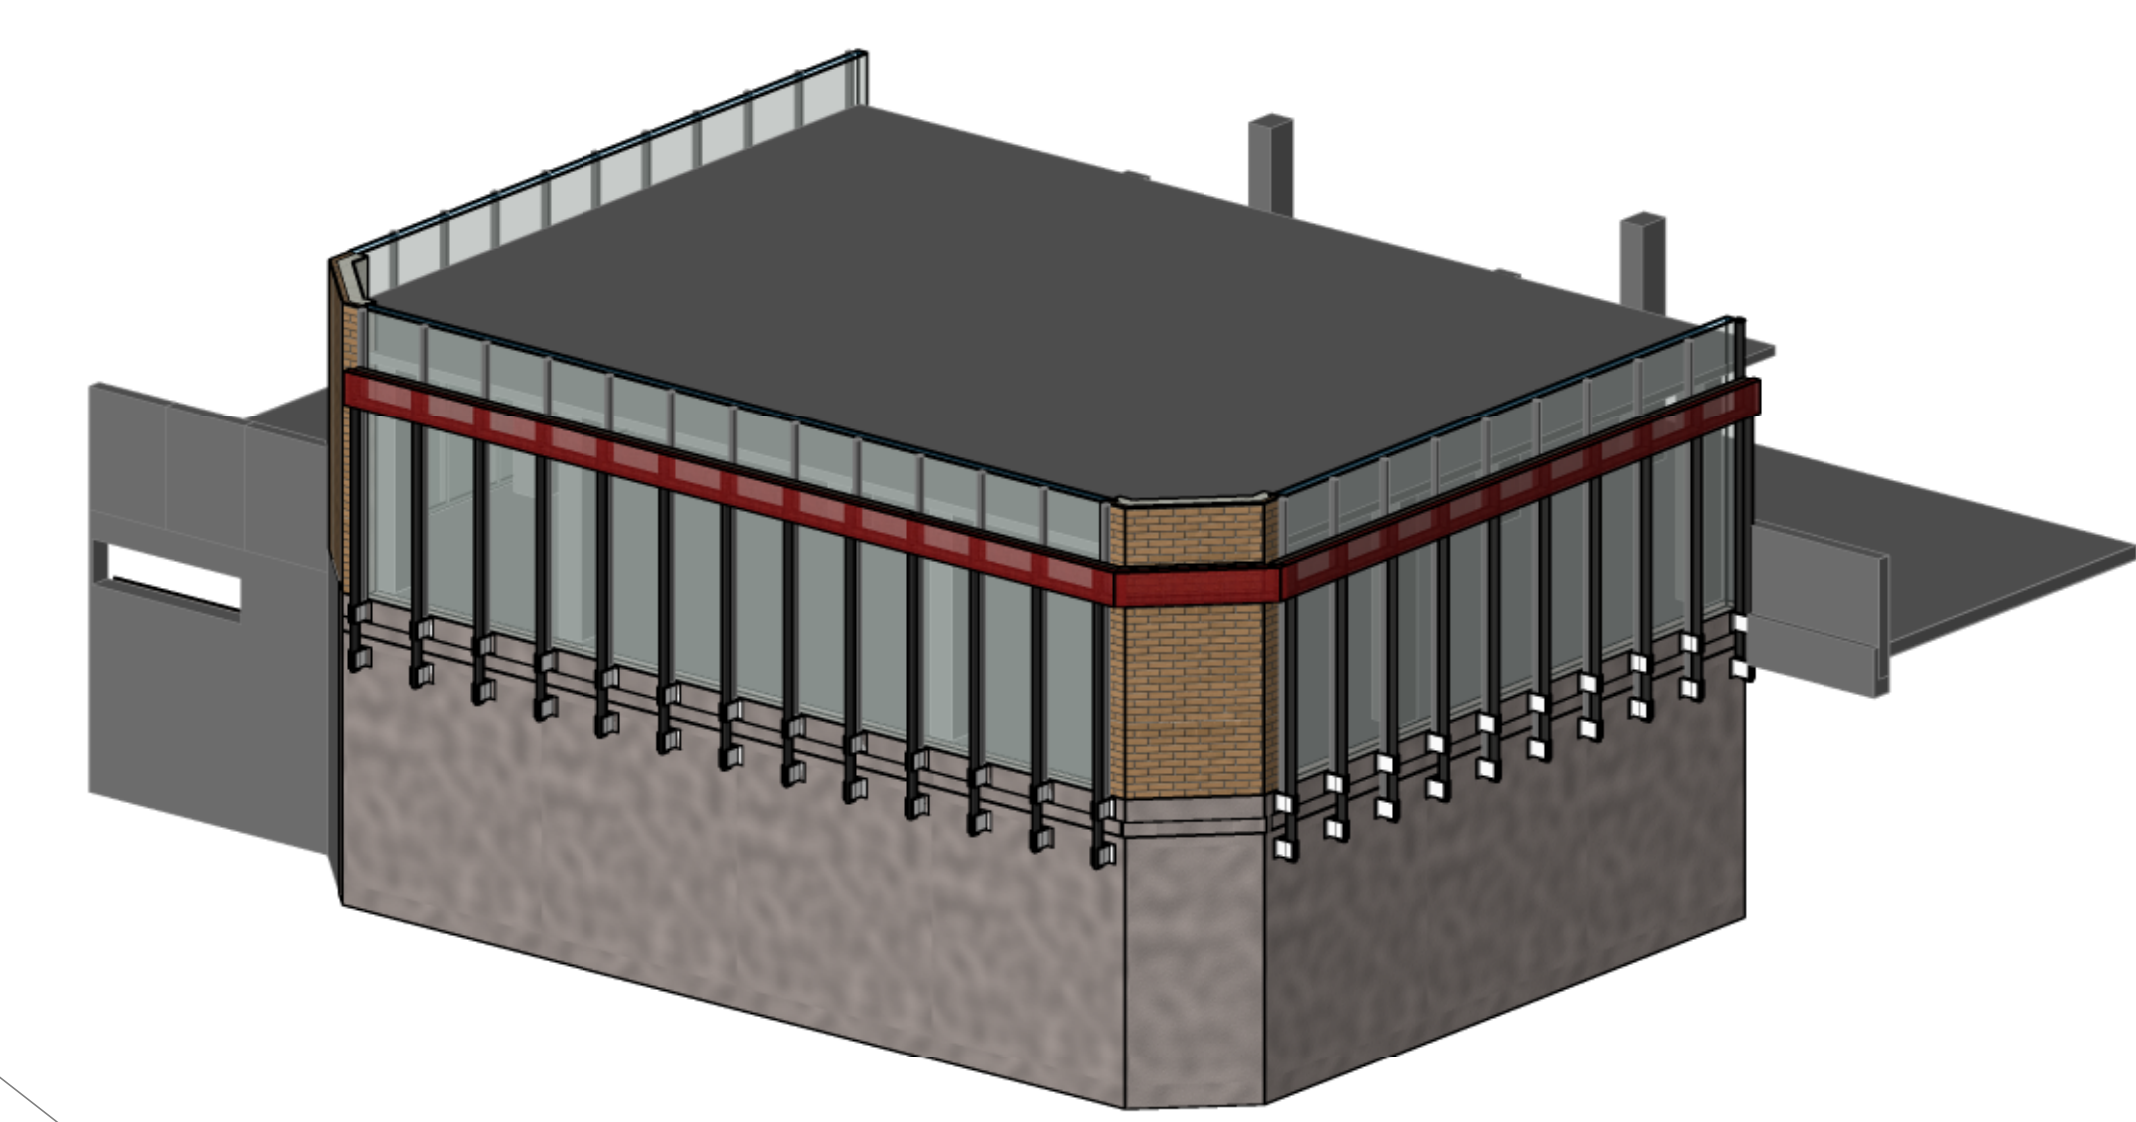



3 ISOMETRIC



1 FIRST LEVEL PART PLAN
 1/4" = 1'-0"

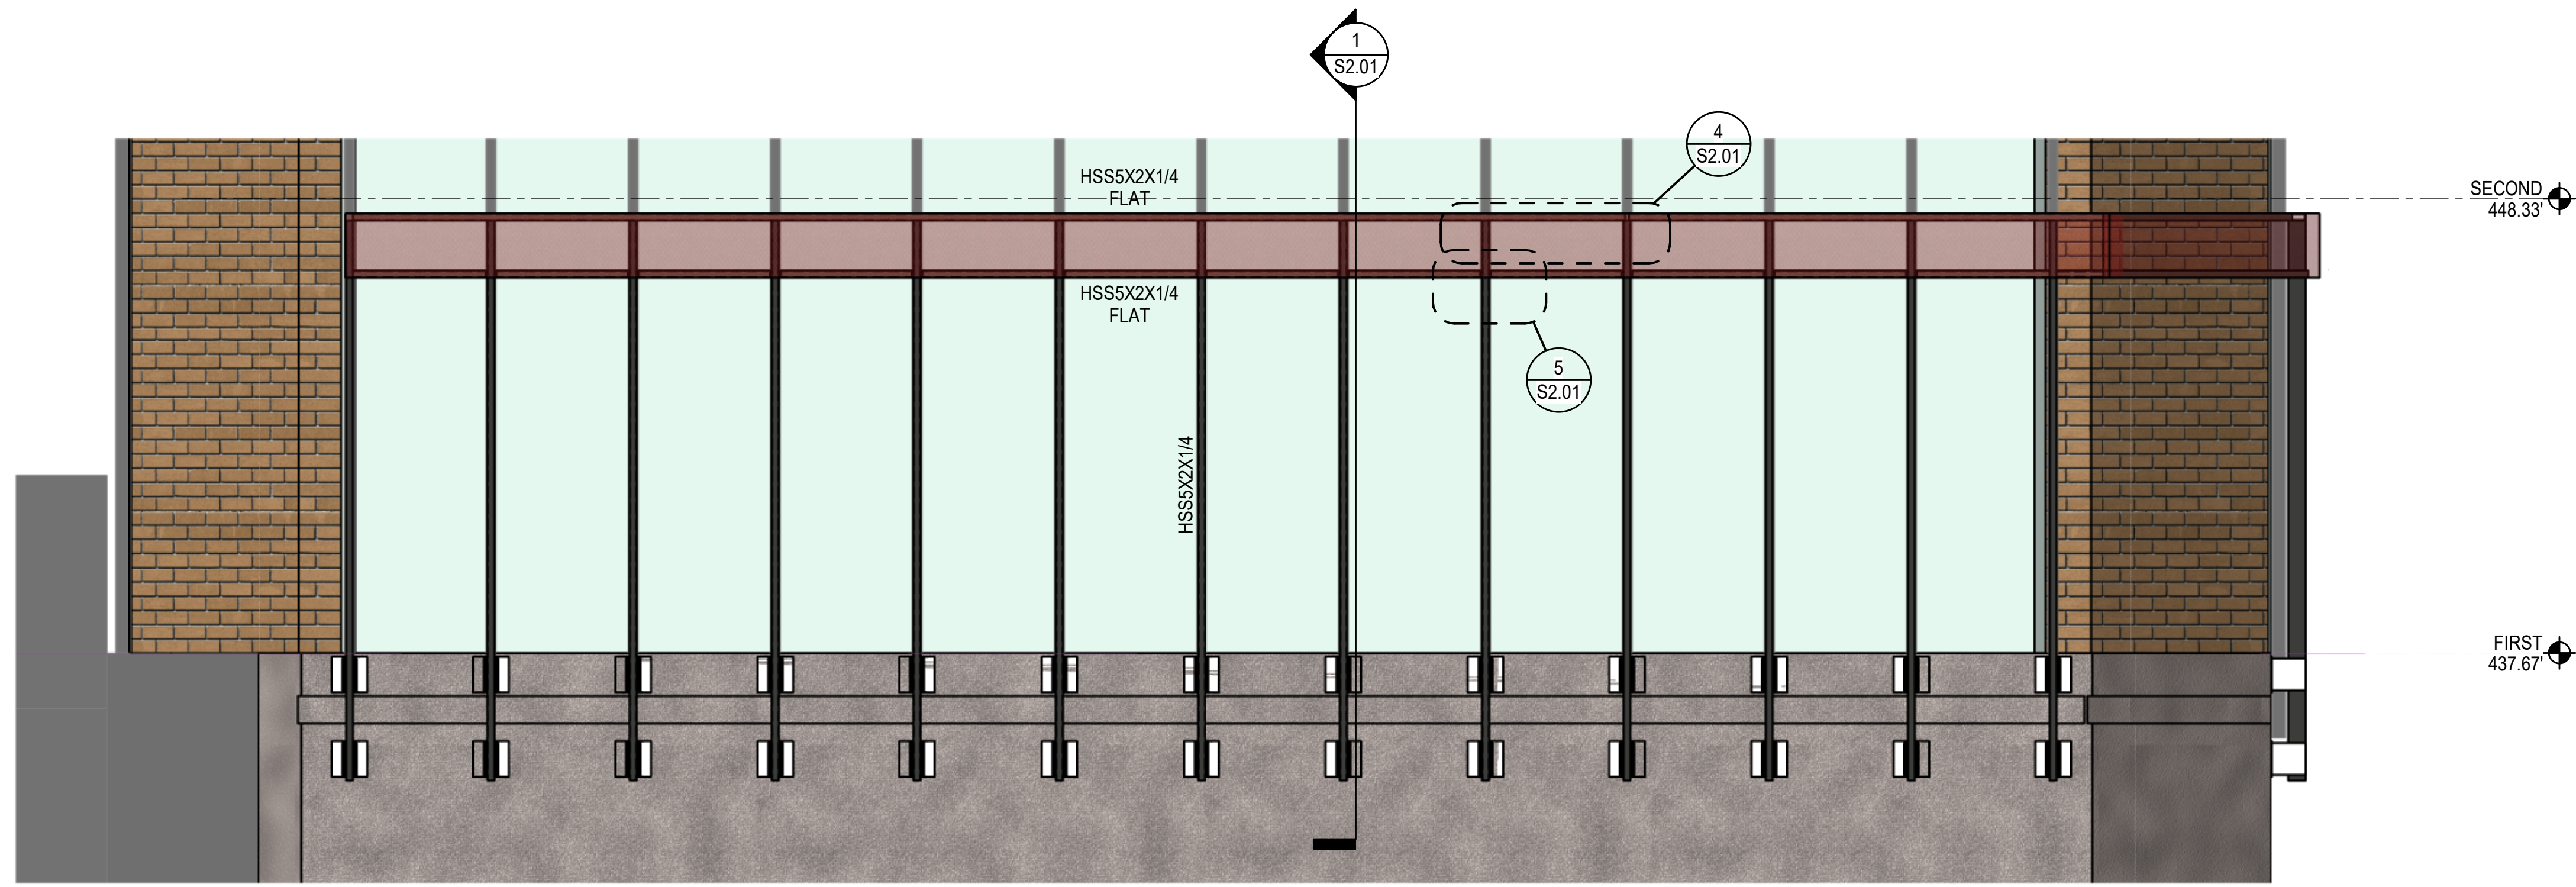

2 FRONT ELEVATION
 3/8" = 1'-0"

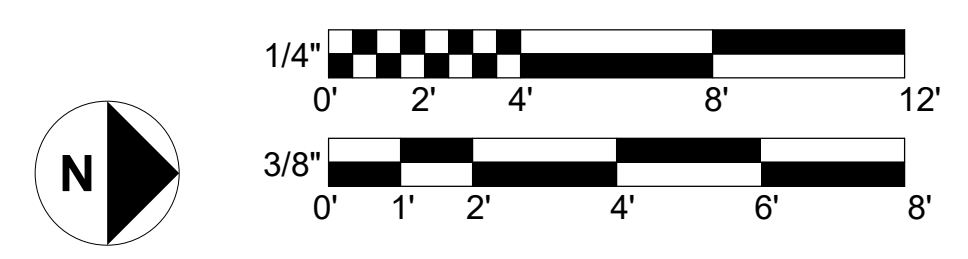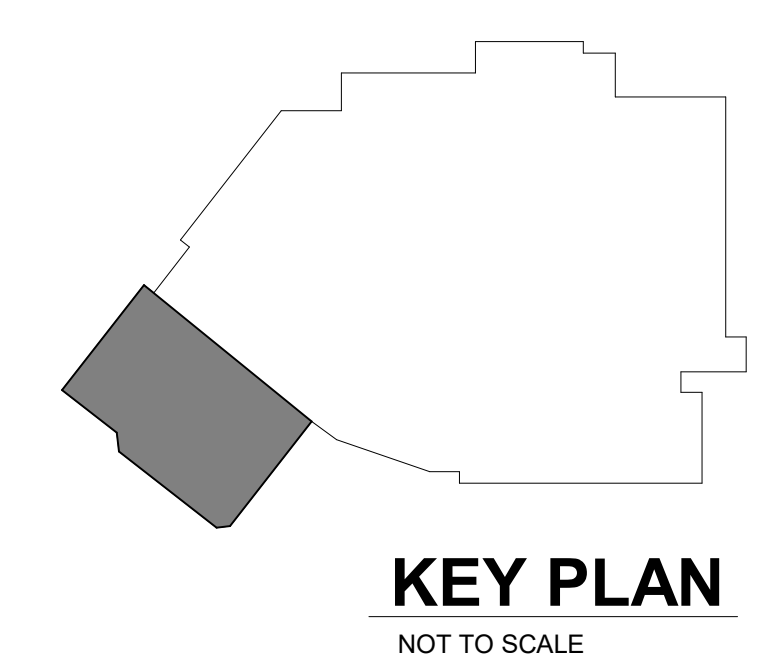

PROGRESS SUBMISSION - NOT FOR CONSTRUCTION

SEAL:

PROFESSIONAL CERTIFICATION:
 I HEREBY CERTIFY THAT THESE DOCUMENTS WERE PREPARED OR APPROVED BY ME, AND THAT I AM A DULY LICENSED PROFESSIONAL ENGINEER UNDER THE LAWS OF THE STATE OF MARYLAND.
 LICENSE NO. 24086
 EXPIRATION DATE: 02-01-2021

ISSUED FOR:

DATE:	DESCRIPTION:
2020-03-06	100% CD
2020-03-25	ADDENDUM #1

PROJECT NO: A+F # 18014.2

SCALE: AS NOTED

DRAWN BY:

CHECKED BY:

DATE: 03/06/2020

SHEET TITLE:
PLANS & ELEVATION

DRAWING NO:

S1.01



SEAL:

PROFESSIONAL CERTIFICATION:
 PROFESSIONAL CERTIFICATION: I HEREBY CERTIFY THAT THESE DOCUMENTS WERE PREPARED OR APPROVED BY ME, AND THAT I AM A DULY LICENSED PROFESSIONAL ENGINEER UNDER THE LAWS OF THE STATE OF MARYLAND. LICENSE NO. 24086 EXPIRATION DATE: 02-01-2021

ISSUED FOR:

DATE:	DESCRIPTION:
2020-03-06	100% CD
2020-03-25	ADDENDUM #1

PROJECT NO: A+F # 18014.2

SCALE: AS NOTED

DRAWN BY:


CHECKED BY:

DATE: 03/06/2020

SHEET TITLE:
SECTIONS & DETAILS


DRAWING NO:

S2.02

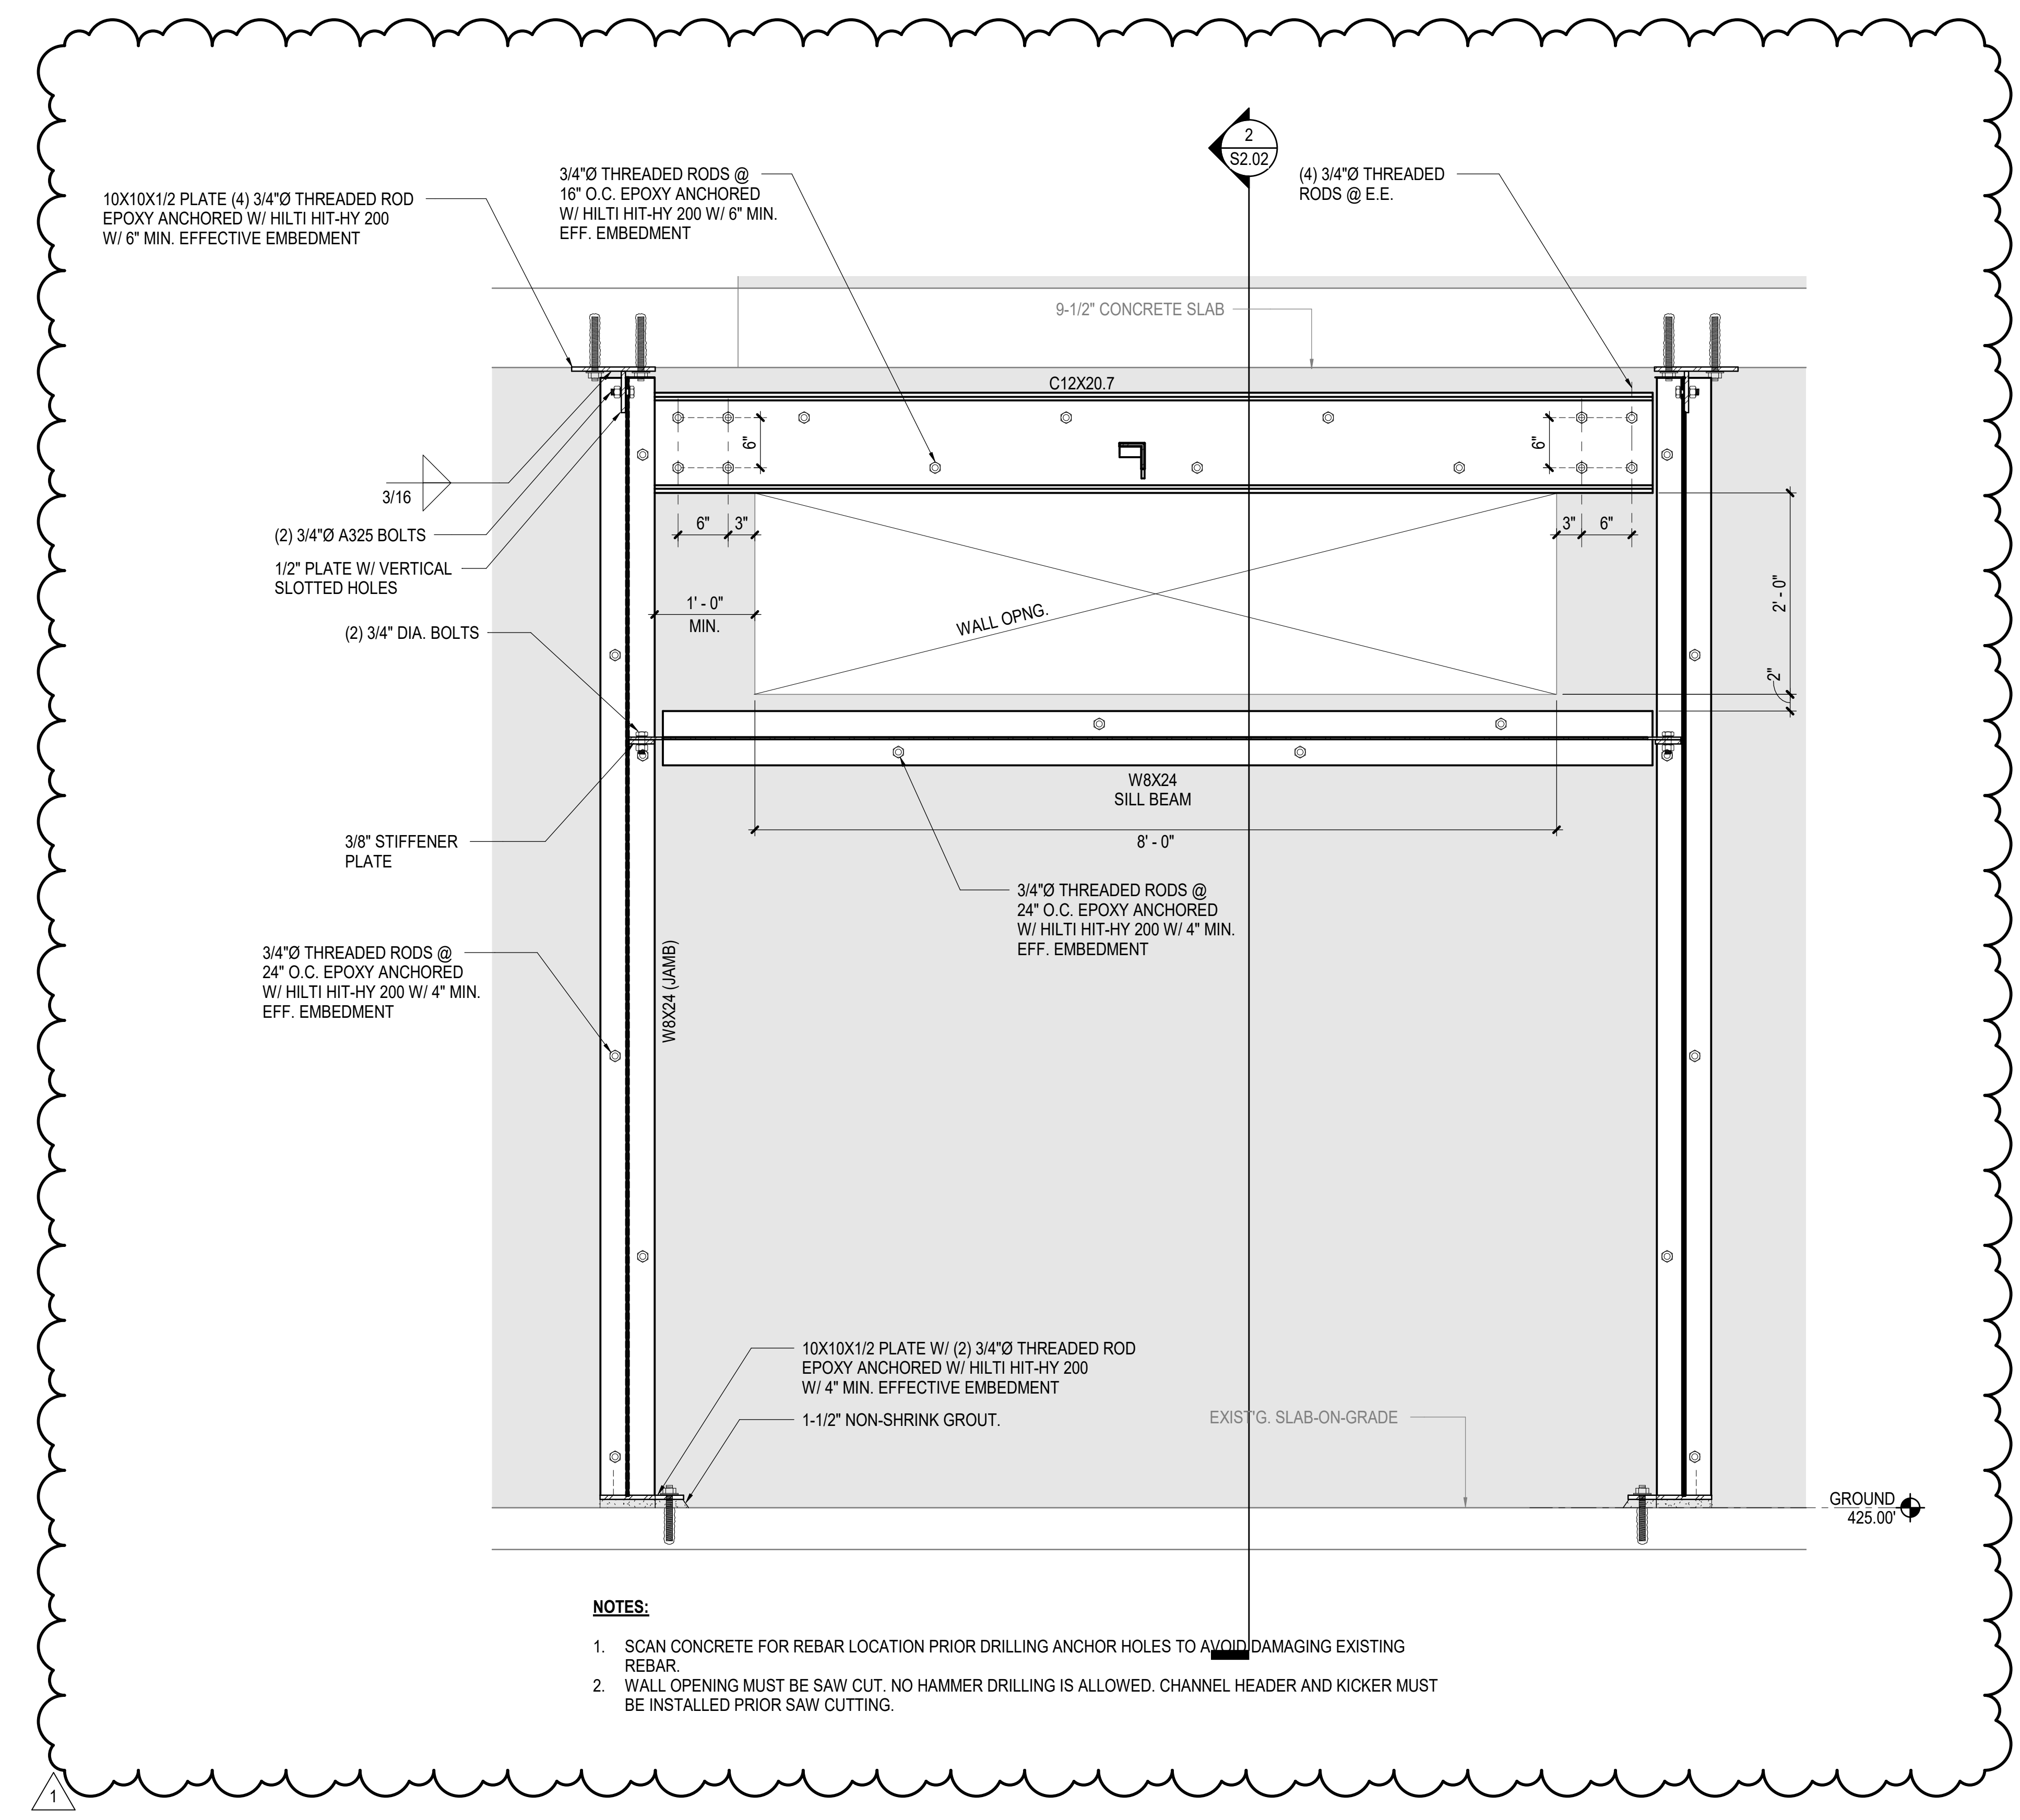


- NOTES:**
1. SCAN CONCRETE FOR REBAR LOCATION PRIOR DRILLING ANCHOR HOLES TO AVOID DAMAGING EXISTING REBAR.
 2. WALL OPENING MUST BE SAW CUT. NO HAMMER DRILLING IS ALLOWED. CHANNEL HEADER AND KICKER MUST BE INSTALLED PRIOR SAW CUTTING.

1 WALL OPENING REINFORCING DETAIL
 1" = 1'-0"

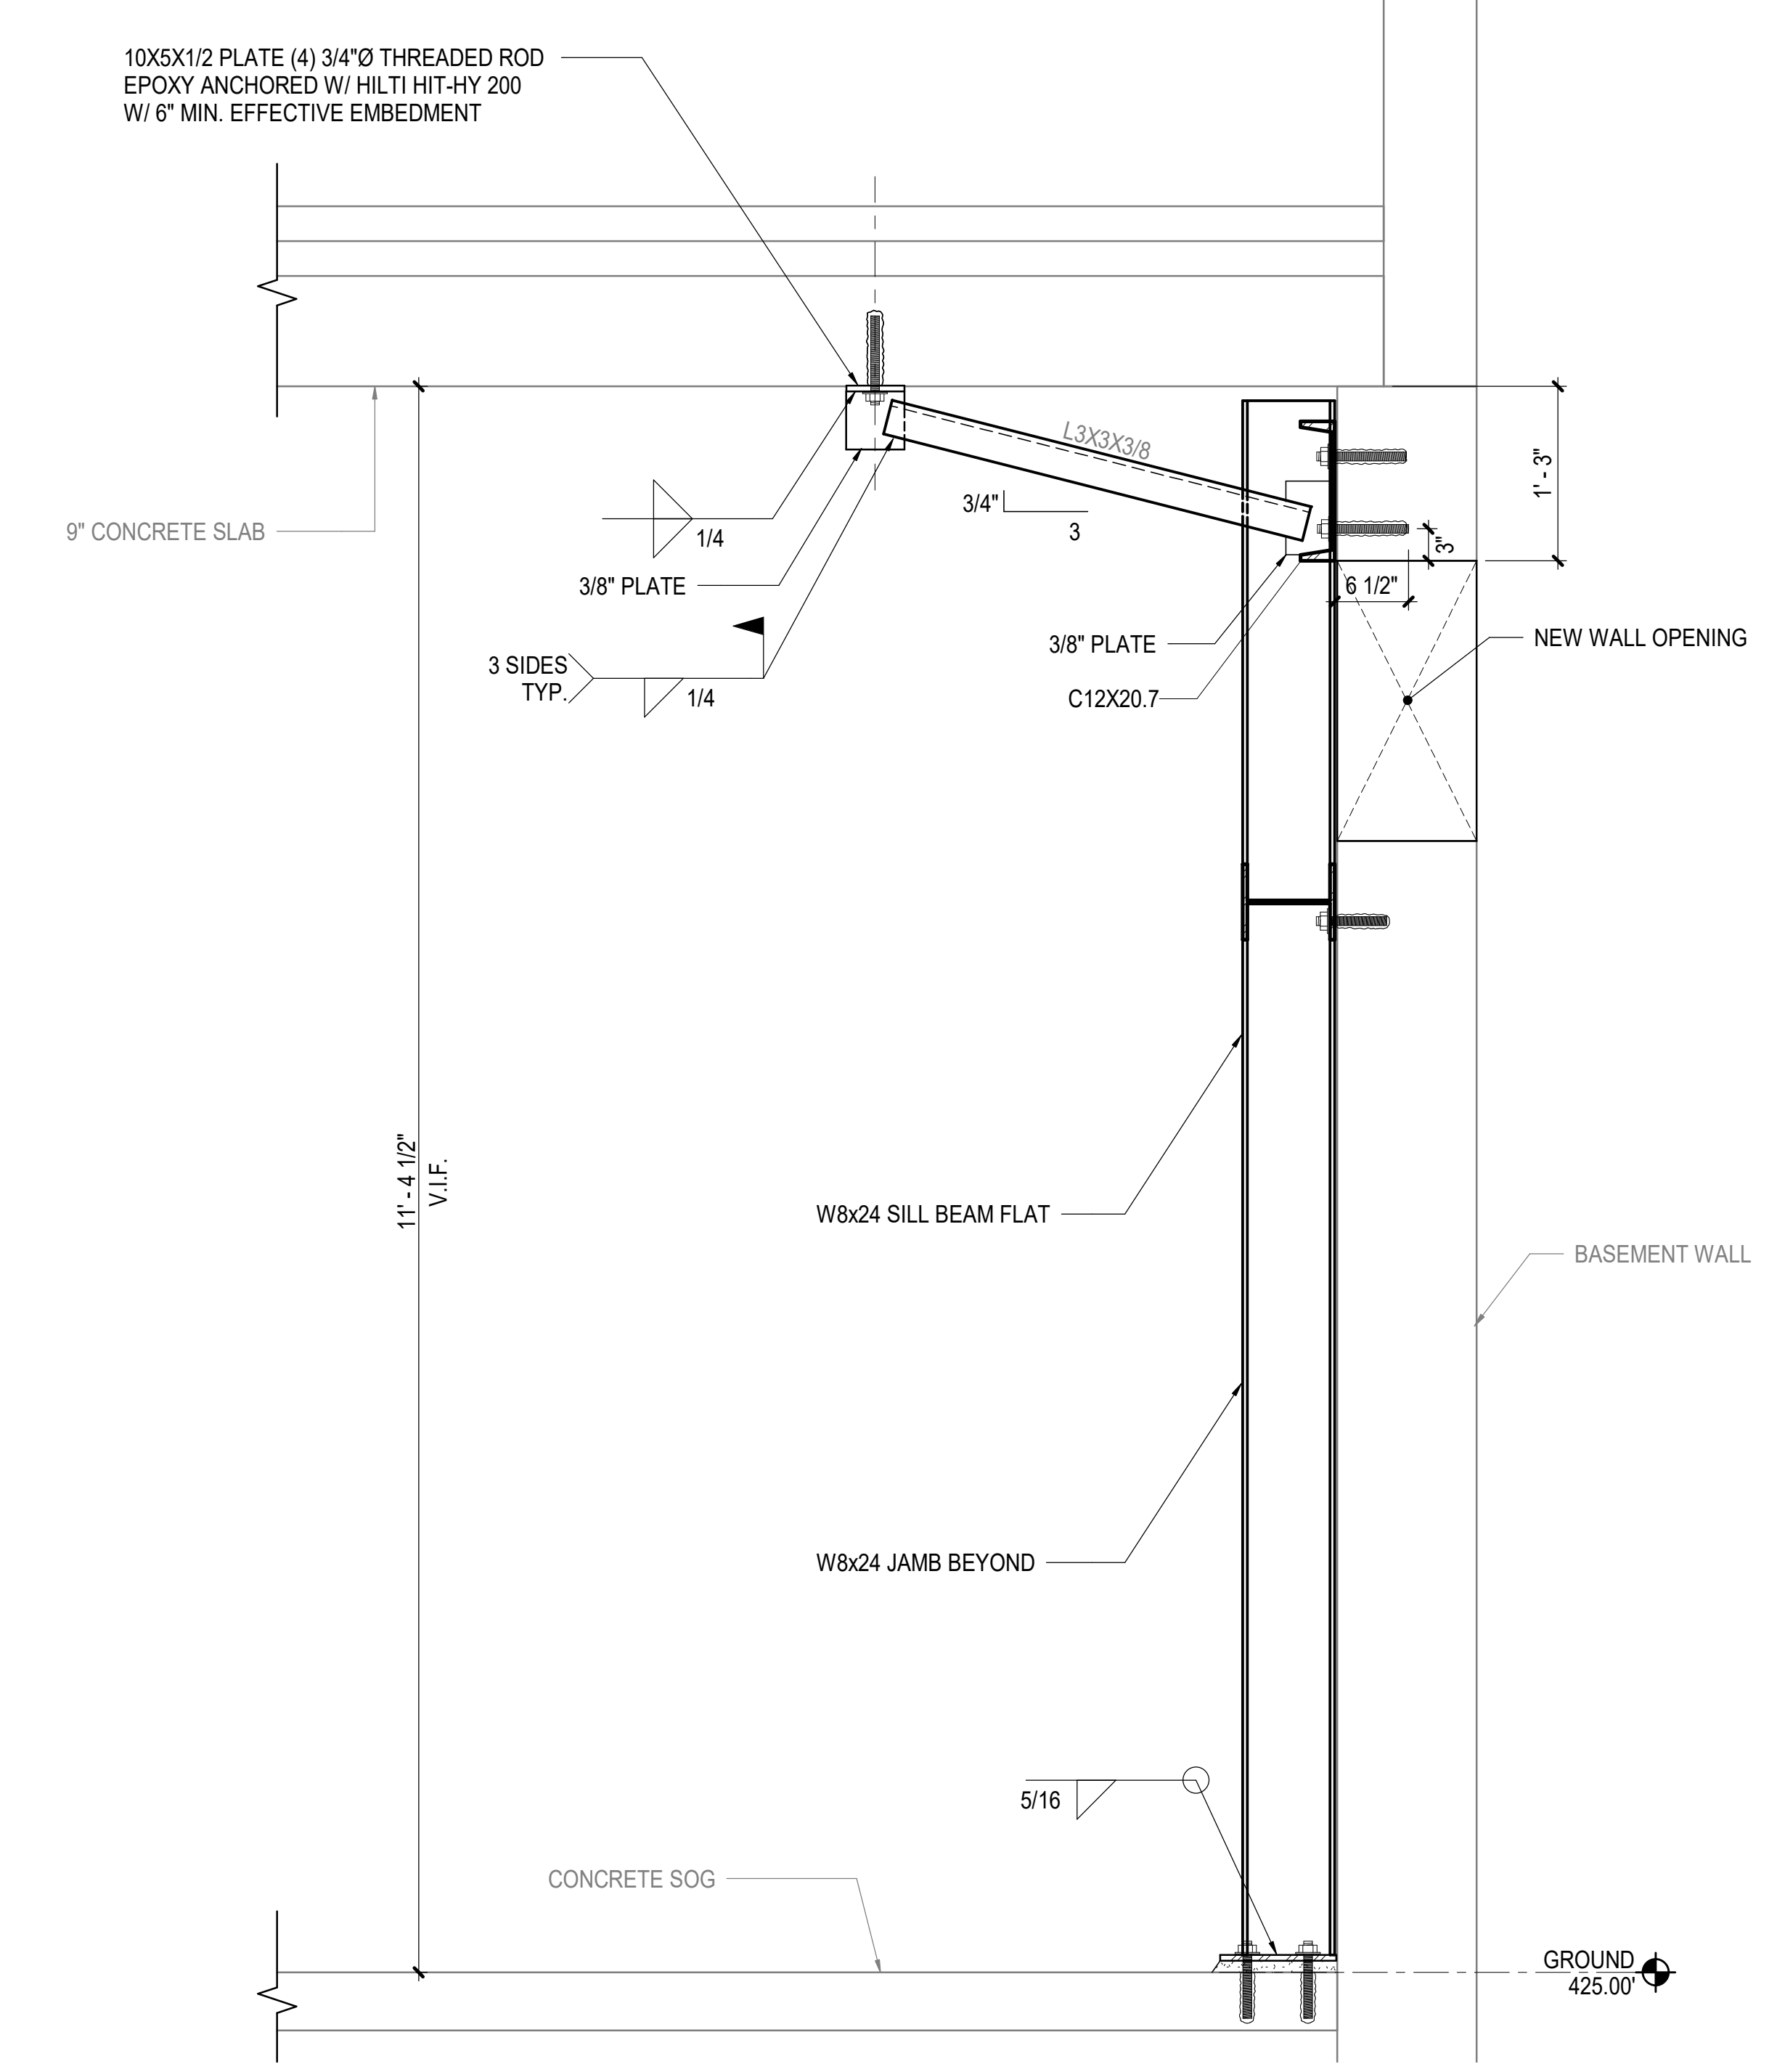

2 BRACE CONNECTION DETAIL
 1" = 1'-0"

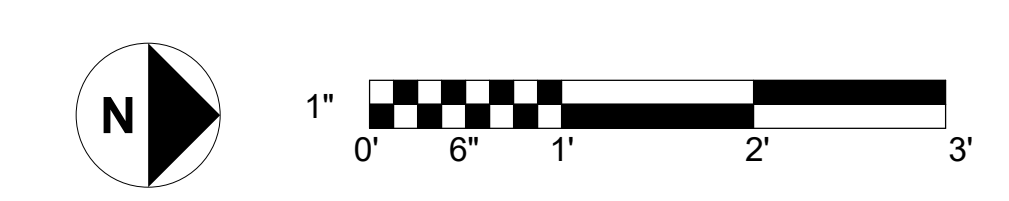



Central Administration
 Office of Facilities
 9221 Corporate Boulevard
 Rockville, MD 20850
 Telephone: 240-567-7363

**MACKLIN TOWER
 MBI SUITE
 RENOVATIONS**



QUINN EVANS ARCHITECTS
 100 N. Charles Street | 410.576.0440
 14th Floor | Baltimore, MD 21201 | www.quinnevans.com

SEAL:

PROFESSIONAL CERTIFICATION:

PROFESSIONAL CERTIFICATION. I HEREBY CERTIFY THAT THESE DOCUMENTS WERE PREPARED OR APPROVED BY ME, AND THAT I AM A DULY LICENSED PROFESSIONAL ENGINEER UNDER THE LAWS OF THE STATE OF MARYLAND.
 LICENSE NO. 13613
 EXPIRATION DATE: 09/08/2021

ISSUED FOR:

DATE:	DESCRIPTION:
3/6/2020	100% CONSTRUCTION DOCUMENTS
3/25/2020	ADDENDUM #1

PROJECT NO: BKM # 19106.01

SCALE: AS NOTED

DRAWN BY: NM

CHECKED BY: BO

DATE: 03/06/2020

SHEET TITLE: GROUND FLOOR PLAN

DRAWING NO:

A101

BKM# 19106.01




PROVIDE WALL SLEEVE AT NEW PENETRATION. PROVIDE WATERPROOF SEAL AT NEW PENETRATION - SEE STRUCTURAL DRAWINGS FOR LOCATION.

1
 A101 GROUND LEVEL
 1/8" = 1'-0"

GENERAL NOTES	
G 1	PERFORM WORK IN ACCORDANCE WITH APPLICABLE LAWS, ORDINANCES, CODES AND REQUIREMENTS. GENERAL CONTRACTOR SHALL OBTAIN ALL PERMITS AND APPROVALS AS REQUIRED FOR THE COMPLETION OF THE WORK BY THE AUTHORITY HAVING JURISDICTION.
G 2	ALTHOUGH INTENDED TO CONVEY APPROPRIATE INFORMATION, THESE DRAWINGS HAVE BEEN PREPARED FROM LIMITED FIELD MEASUREMENTS. AS SUCH, DRAWINGS MAY CONTAIN DISCREPANCIES DUE TO CONCEALED CONDITIONS, INACCURACIES IN ORIGINAL DRAWINGS, INACCESSIBLE LOCATIONS, UNRECORDED BUILDING ALTERATIONS, AND OTHER CONFLICTING INFORMATION. CONTRACTOR SHALL FIELD VERIFY EXISTING CONDITIONS AND MEASUREMENTS. NOTIFY ARCHITECT REGARDING DISCREPANCIES BETWEEN EXISTING CONDITIONS AND THE CONTRACT DOCUMENTS PRIOR TO COMMENCING WORK.

NEW WORK LEGEND	
	EXISTING WALL TO REMAIN
	GWV WALL
	EXTENT OF CONC SLABS
	EXISTING DOOR
	DOOR

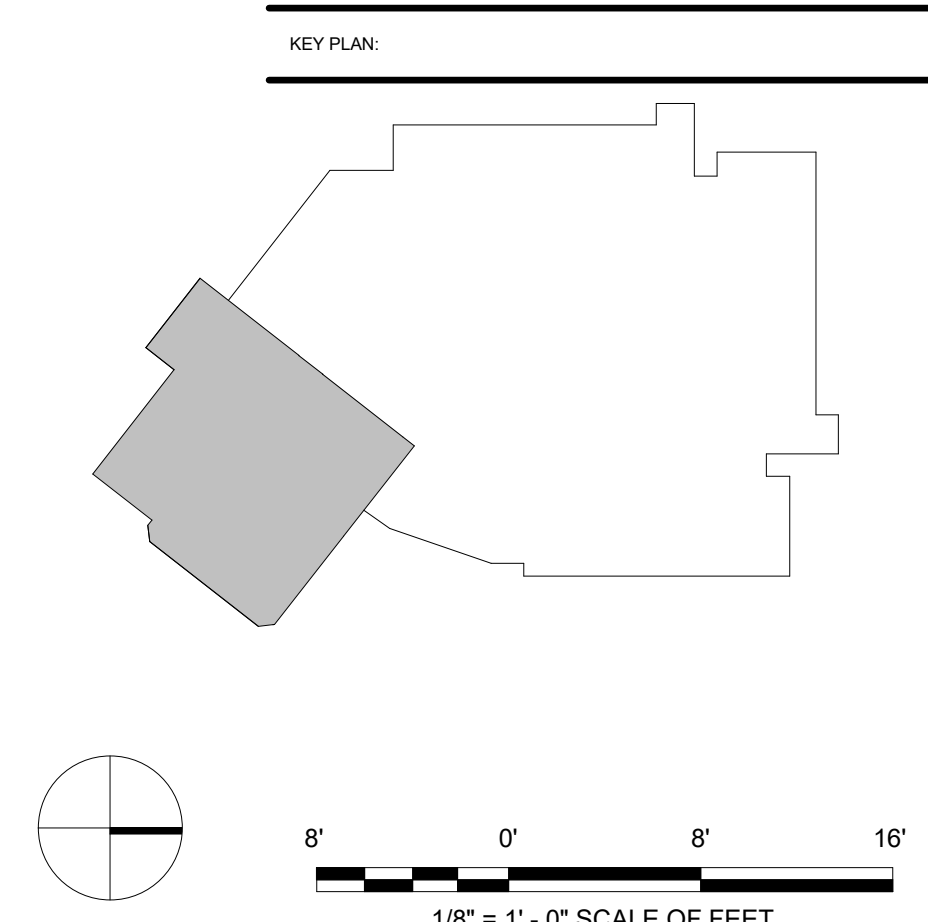


PLOTTED BY: James Worevel | 11/15/2019 9:26 AM
 ARL: C:\19106.01\Drawings\Acad\Plot\p19106.01.dwg



Central Administration
 Office of Facilities
 9221 Corporate Boulevard
 Rockville, MD 20850
 Telephone: 240-567-7363

**MACKLIN TOWER
 MBI SUITE
 RENOVATIONS**

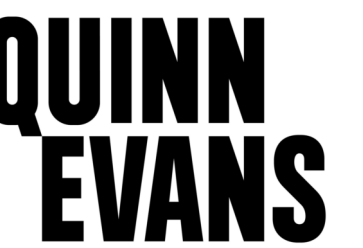

QUINN EVANS ARCHITECTS
 100 N. Charles Street 410.576.0440
 14th Floor Rockville, MD 20850 www.quinnevans.com
 Baltimore, MD 21201

SEAL:

PROFESSIONAL CERTIFICATION:

PROFESSIONAL CERTIFICATION: I HEREBY CERTIFY THAT THESE DOCUMENTS WERE PREPARED OR APPROVED BY ME, AND THAT I AM A DULY LICENSED PROFESSIONAL ENGINEER UNDER THE LAWS OF THE STATE OF MARYLAND.
 LICENSE NO. 13613
 EXPIRATION DATE: 09/08/2021

ISSUED FOR:

DATE:	DESCRIPTION:
3/6/2020	100% CONSTRUCTION DOCUMENTS
3/25/2020	ADDENDUM #1

PROJECT NO: BKM # 19106.01

SCALE: AS NOTED

DRAWN BY: NM

CHECKED BY: BO

DATE: 03/06/2020

SHEET TITLE: FIRST FLOOR RCP

DRAWING NO:

A112


BKM# 19106.01



1
 A112
 FIRST FLOOR
 1/8" = 1'-0"

RCP LEGEND

	EXISTING TO REMAIN
	GWB WALL
	2 x 4 ACOUSTIC PANEL
	GWB CEILING

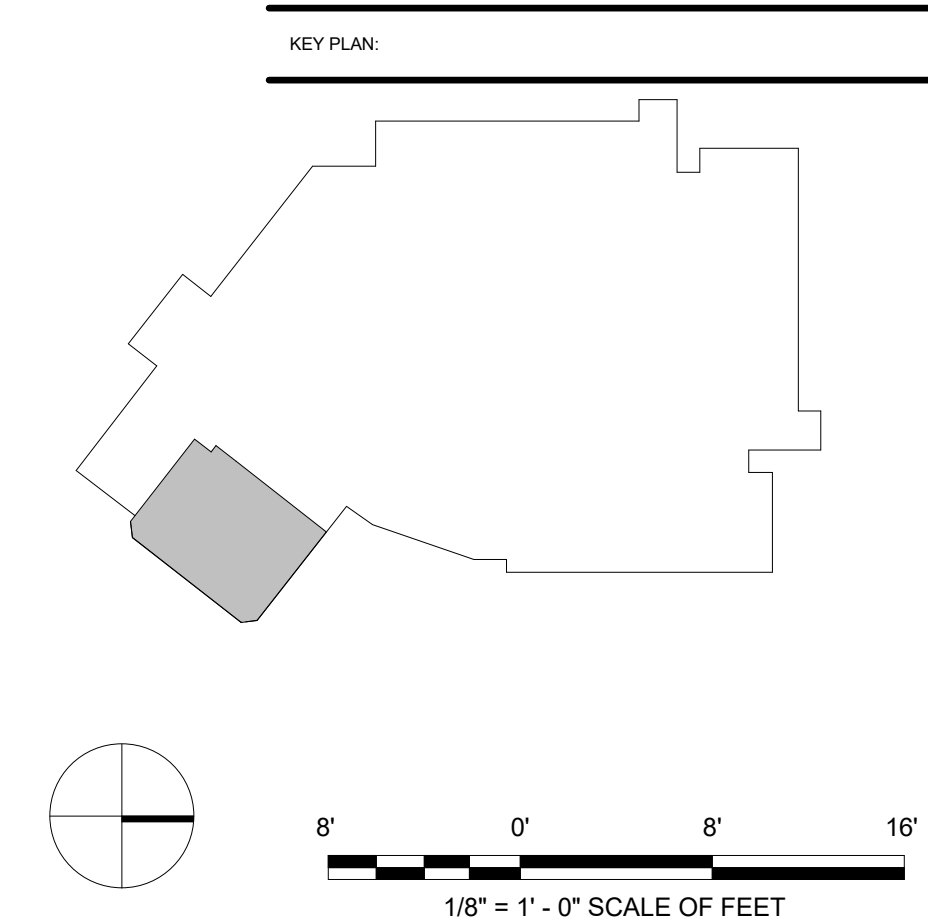



Central Administration
 Office of Facilities
 9221 Corporate Boulevard
 Rockville, MD 20850
 Telephone: 240-567-7363

**MACKLIN TOWER
 MBI SUITE
 RENOVATIONS**



QUINN EVANS ARCHITECTS
 100 N. Charles Street 410.576.0440
 14th Floor Rockville, MD 20850
 Baltimore, MD 21201 www.quinnevans.com

SEAL:

PROFESSIONAL CERTIFICATION: I HEREBY CERTIFY THAT THESE DOCUMENTS WERE PREPARED OR APPROVED BY ME, AND THAT I AM A DULY LICENSED PROFESSIONAL ENGINEER UNDER THE LAWS OF THE STATE OF MARYLAND.
 LICENSE NO. 13613
 EXPIRATION DATE: 09/08/2021

ISSUED FOR:

DATE:	DESCRIPTION:
3/6/2020	100% CONSTRUCTION DOCUMENTS
3/25/2020	ADDENDUM #1

PROJECT NO: BKM # 19106.01

SCALE: AS NOTED

DRAWN BY: NM

CHECKED BY: BO


DATE: 03/06/2020

SHEET TITLE: ENLARGED PLANS AND ELEVATIONS


DRAWING NO:

A401


BKM# 19106.01

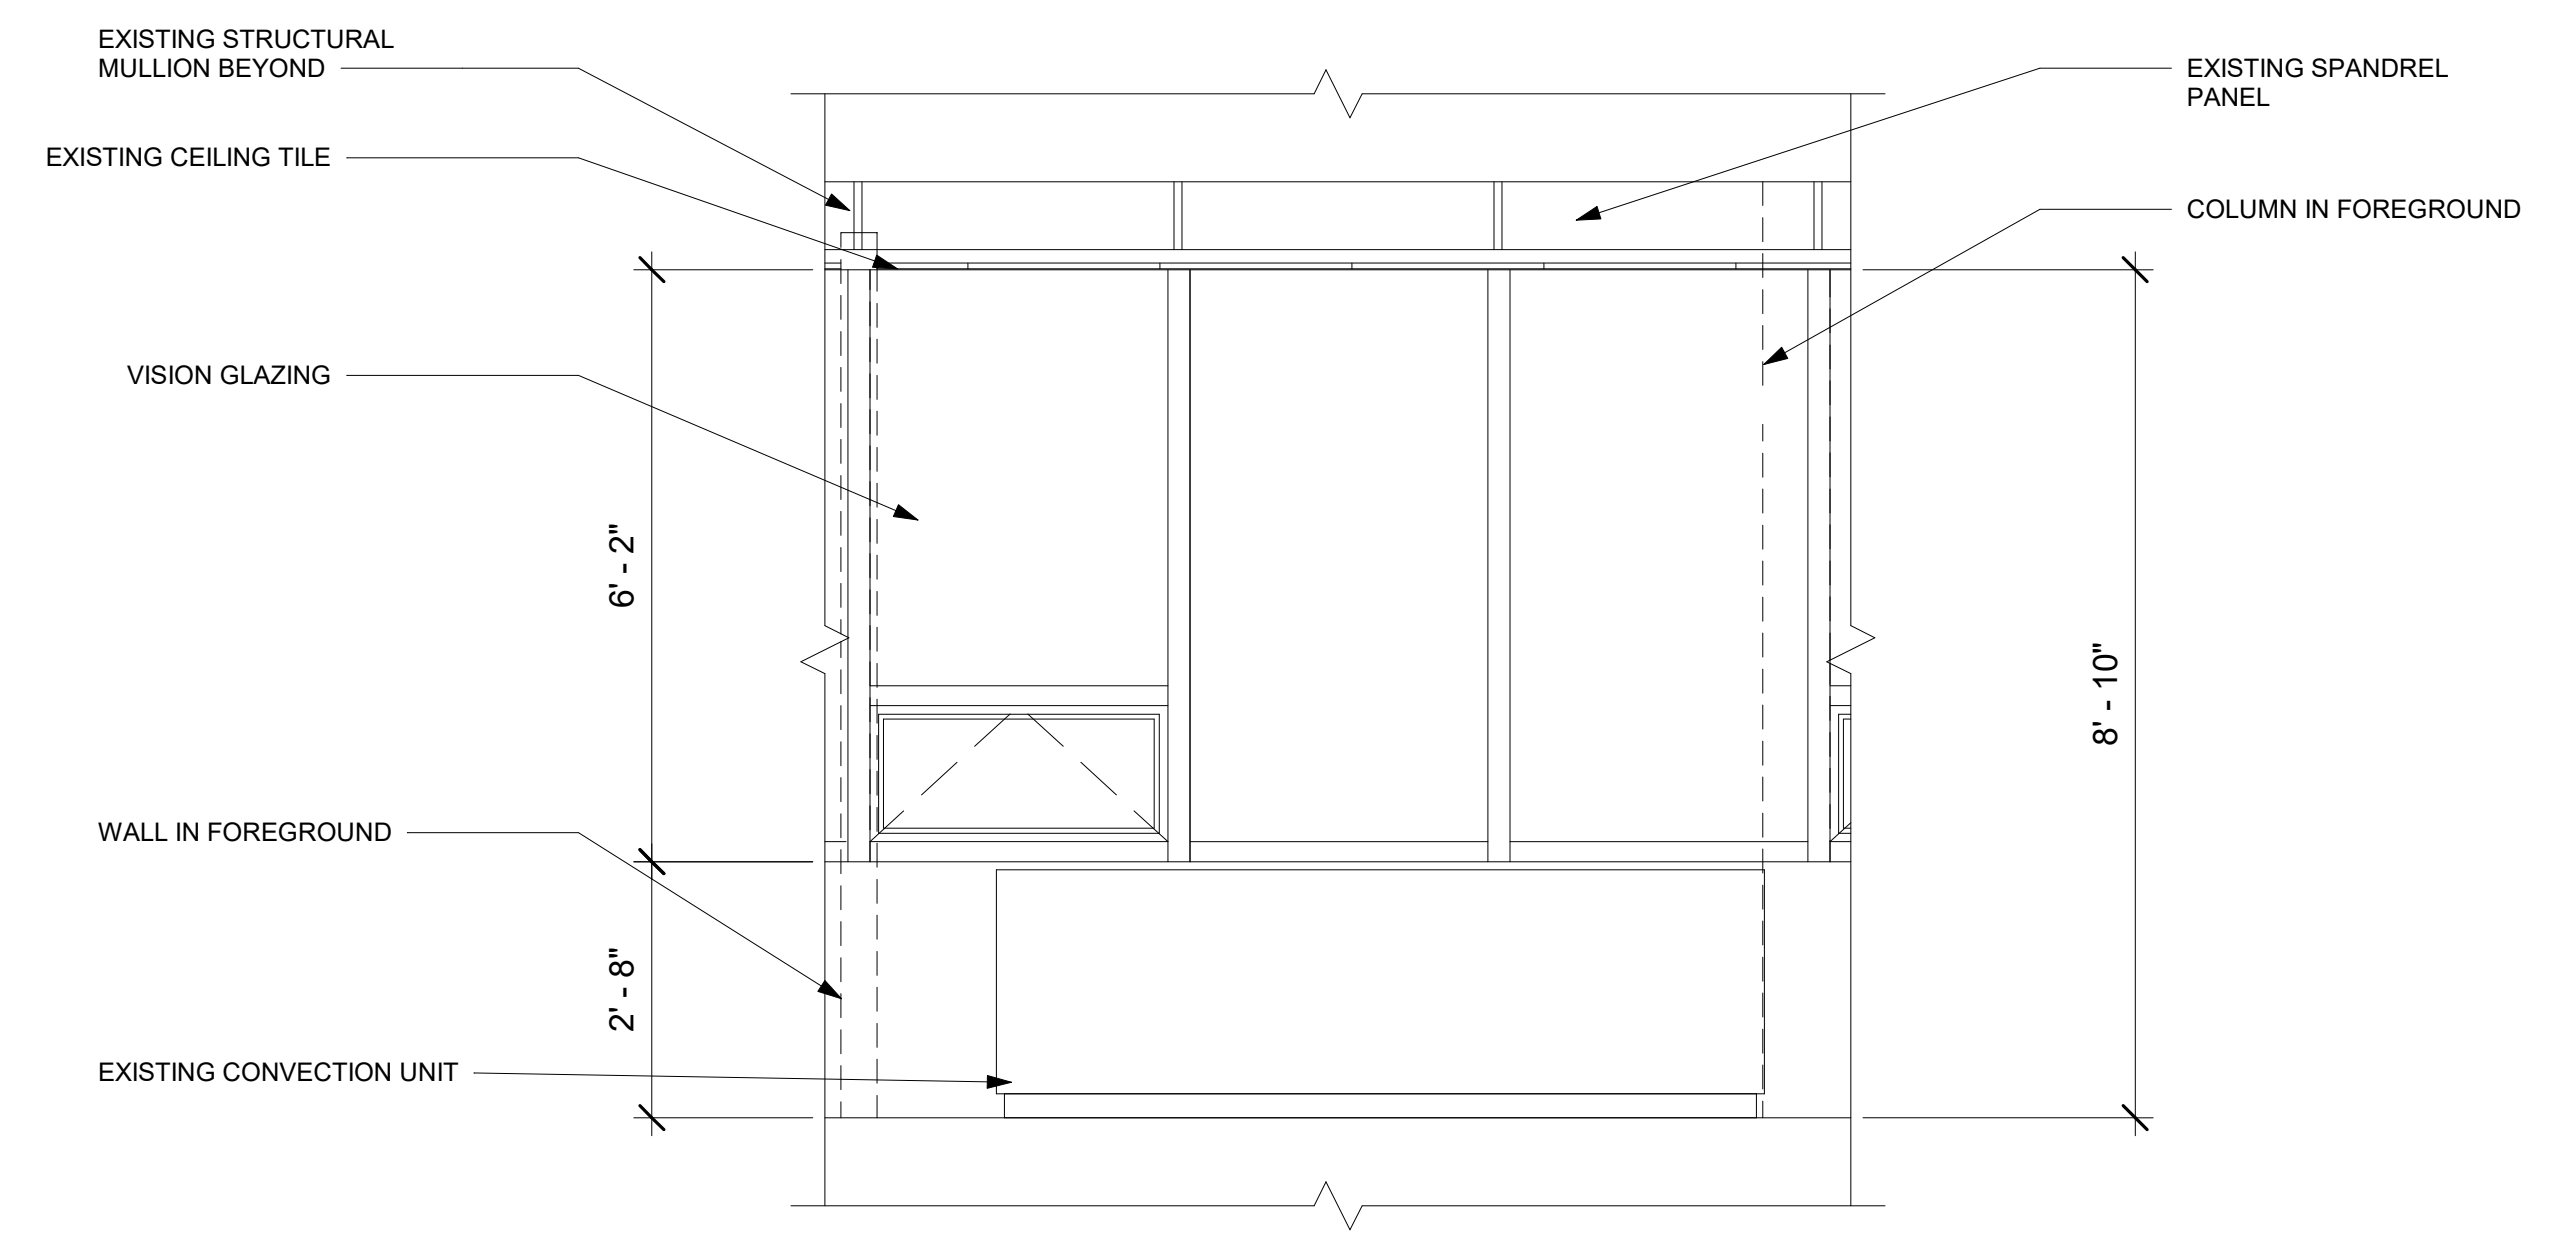


4 EXISTING WINDOW ELEVATION
 1/2" = 1'-0" REFERRED FROM:

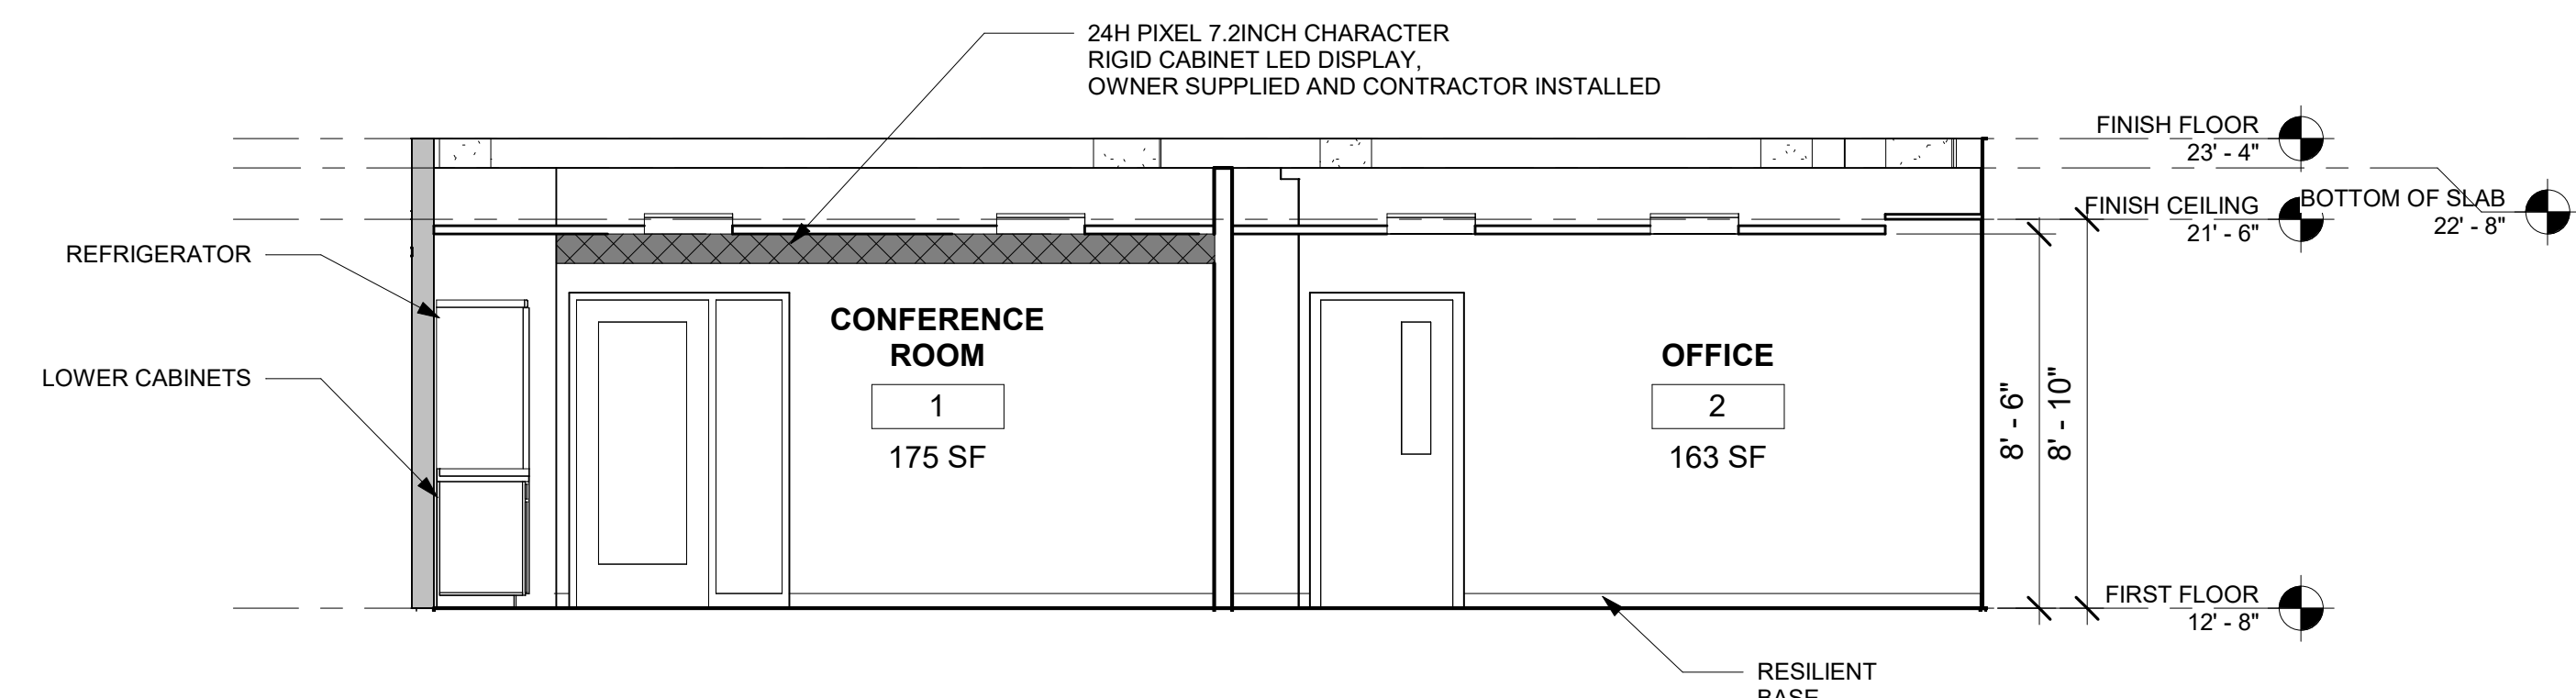


5 Section 3
 1/4" = 1'-0" REFERRED FROM:A401

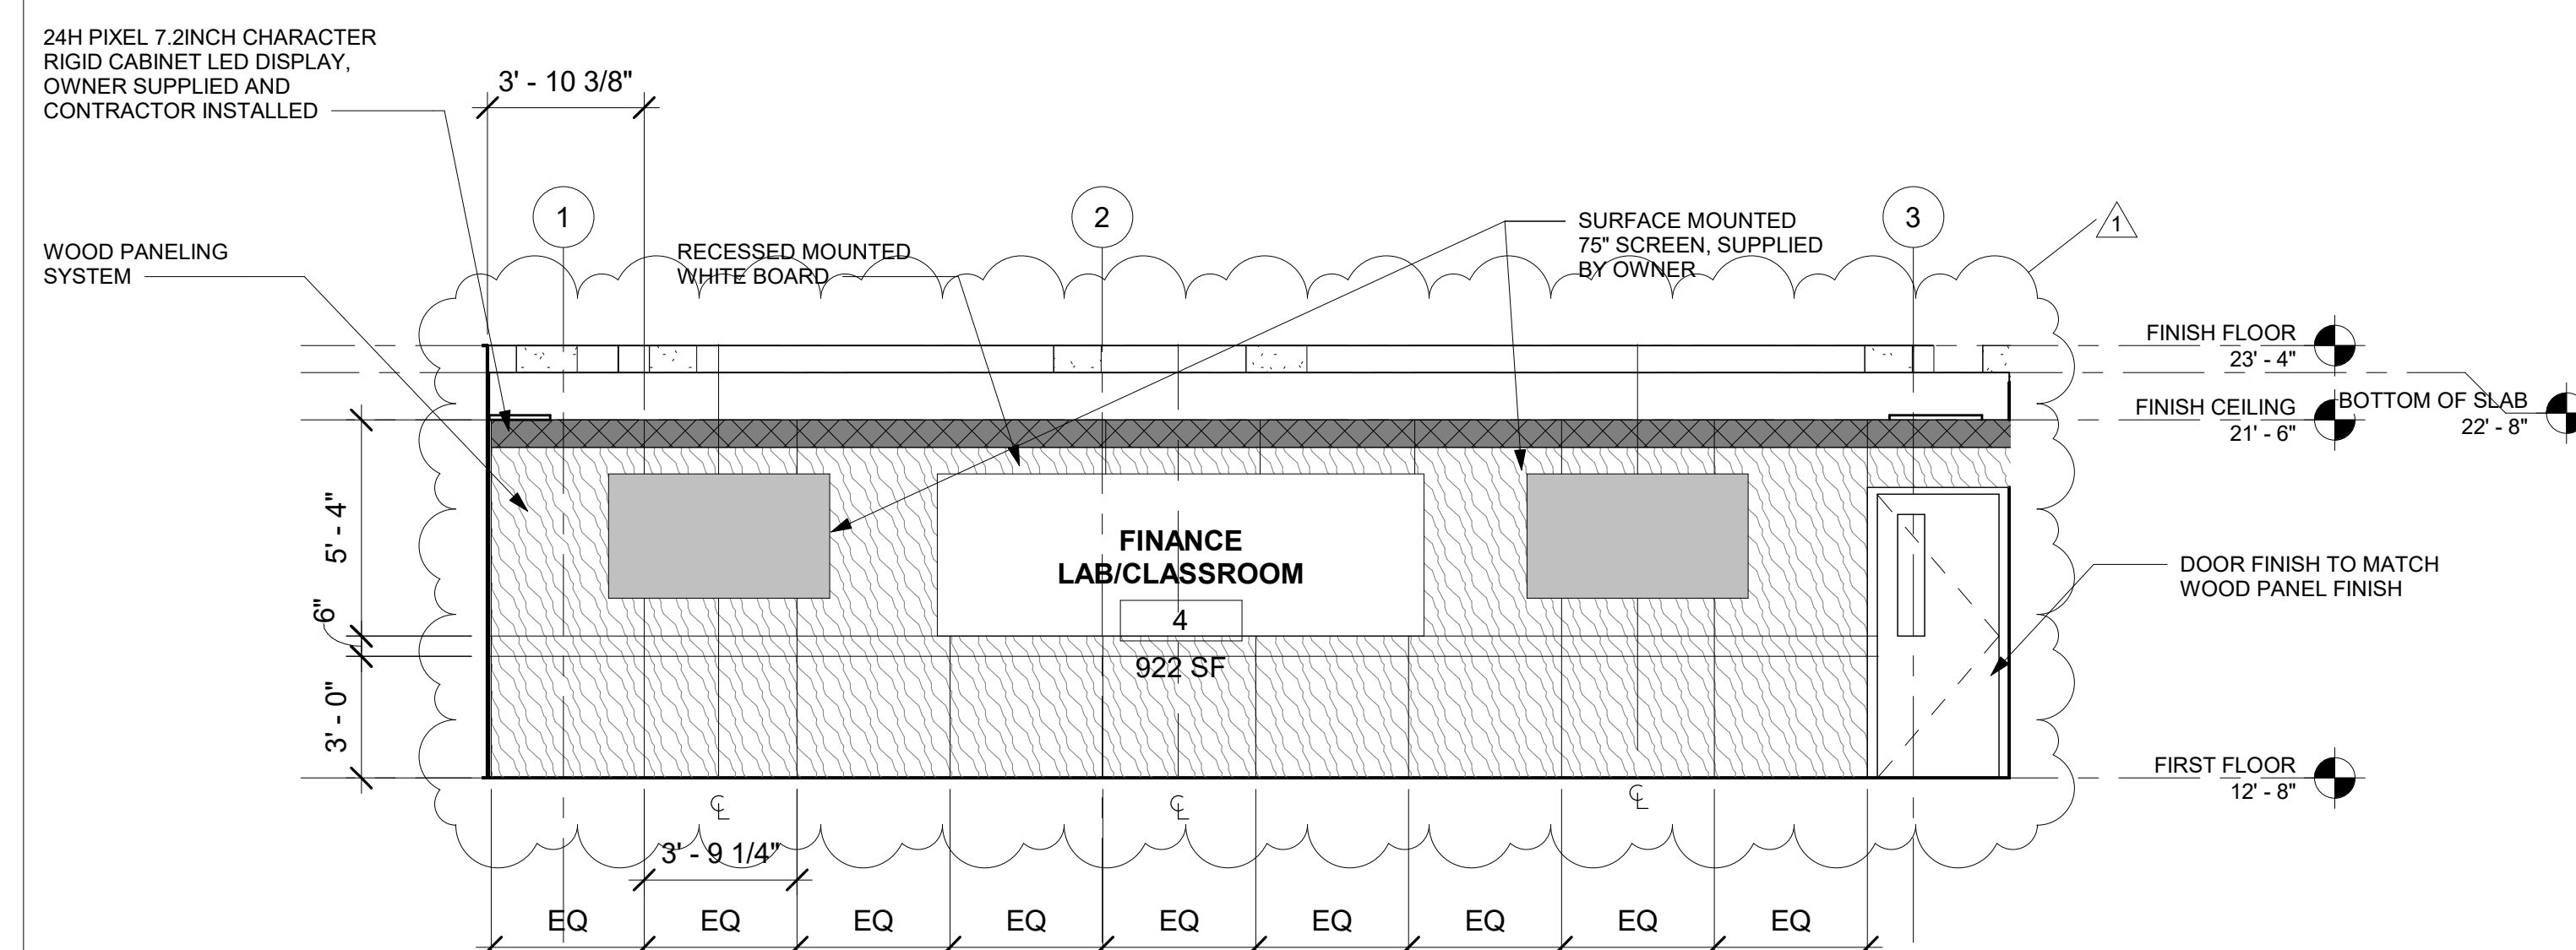

3 Section 2
 1/4" = 1'-0" REFERRED FROM:A401

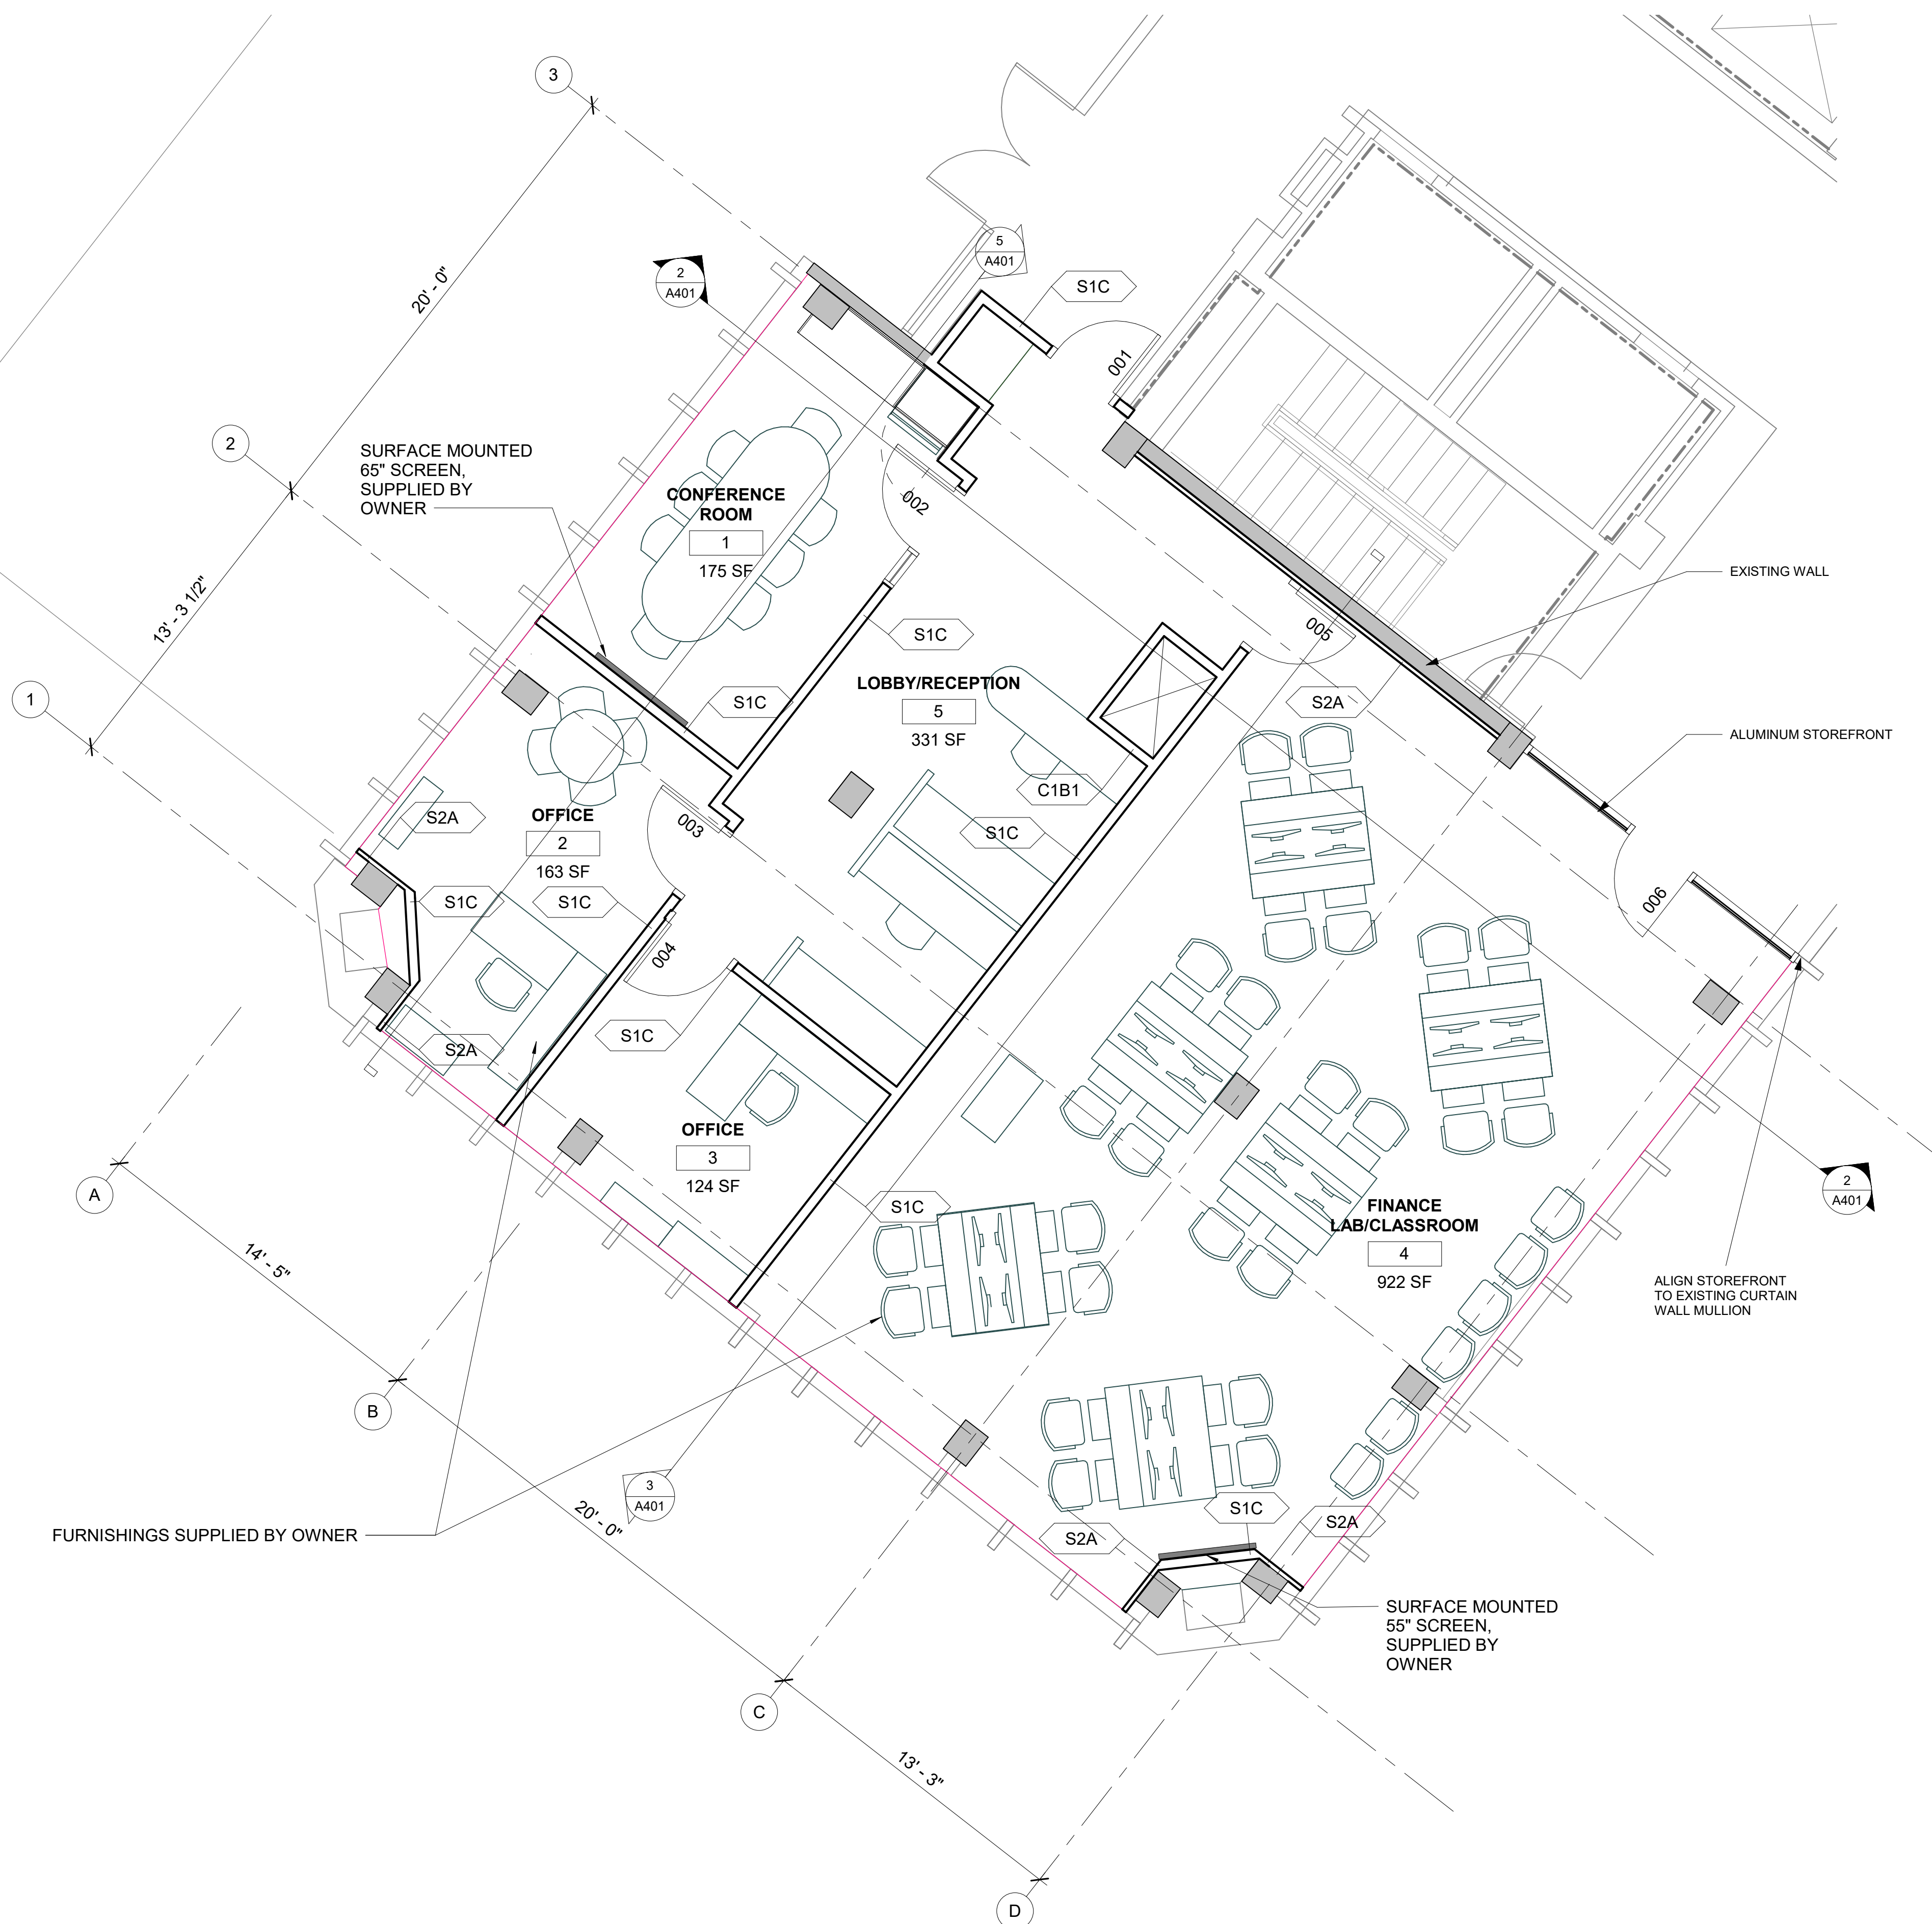


1 FIRST FLOOR FURNITURE PLAN - Callout 1
 1/4" = 1'-0" REFERRED FROM:

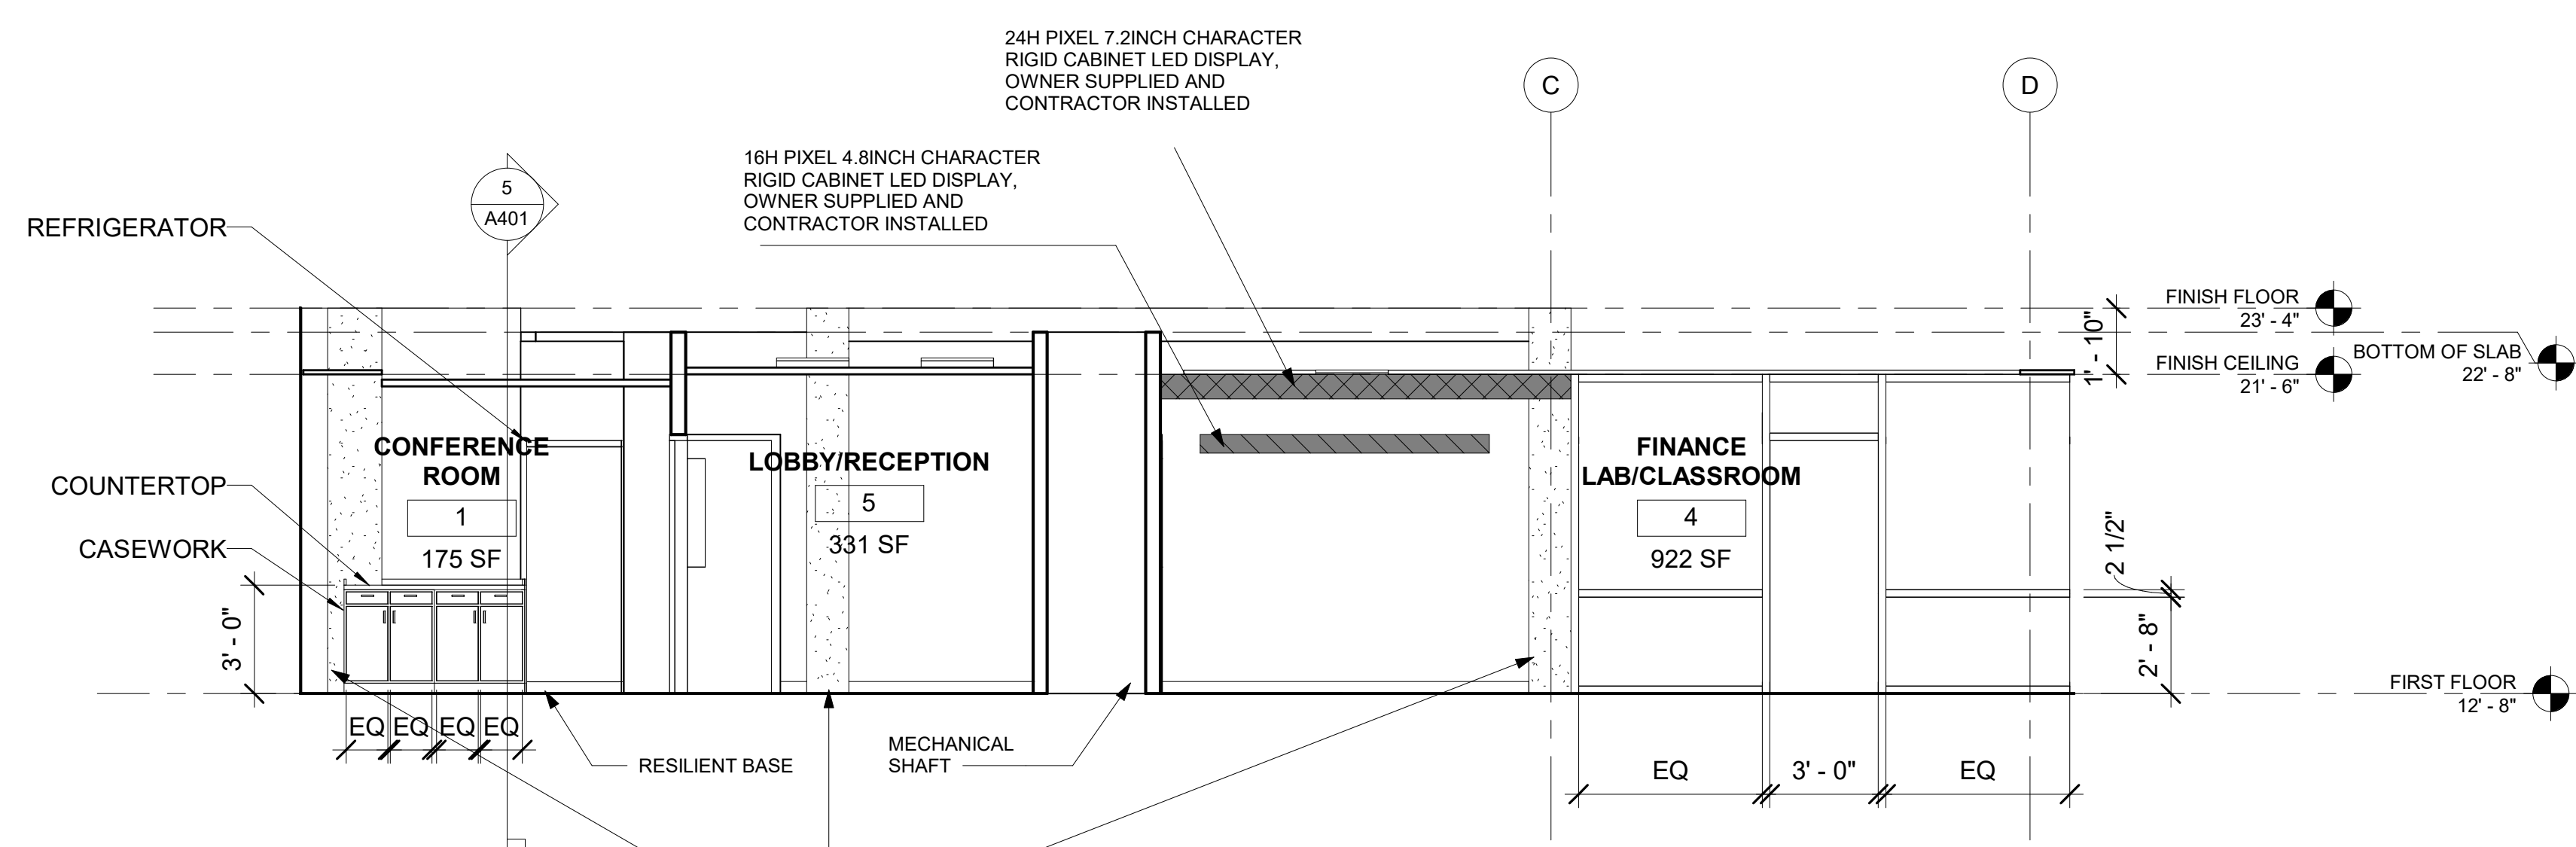


2 Section 1
 1/4" = 1'-0" REFERRED FROM:A401


MATERIAL SCHEDULE									
ITEM MARK	ITEM DESCRIPTION	MANUFACTURER	STYLE NAME/No.	COLOR/PATTERN	FINISH	SIZE	REMARKS	FLAME SPREAD	SMOKE DEVELOPED
AC-1	ACOUSTICAL CEILING TILE	ARMSTRONG	SQUARE MEDIUM TEXTURE #1830 AND #1831		FINE FISSURED	24" x 48" x 5/8"	SUSPENSION TRACK TYPE SS-1, SEE SPECS	25 OR LESS	50 OR LESS
AC-2	ACOUSTICAL CEILING TILE	ARMSTRONG	SQUARE MEDIUM TEXTURE #1830 AND #1831		FINE FISSURED	24" x 24" x 5/8"	SUSPENSION TRACK TYPE SS-1, SEE SPECS	25 OR LESS	50 OR LESS
CPT1	CARPET TILE FLOORING	KINETEX	TIMBER	1923 ASPEN	-	12" x 48"		CLASS 1	450 OR LESS
CPT2	CARPET TILE FLOORING	KINETEX	PROPEL II	1702 GUIDE	-	12" x 48"		CLASS 1	450 OR LESS
VB1	RESILIENT BASE	ROPPE	-	123 CHARCOAL	-	6" x 24", 12" x 24"	4" HIGH BULLNOSE BASE	0.45 W/cm2 OR MORE CLASS 1	450 OR LESS
PT-1	PAINT	BENJAMIN MOORE	#OC-62	BABY'S BREATH	EGGSHELL	-	WALL PAINT - TYP		
PT-2	PAINT	BENJAMIN MOORE	-	-	EGGSHELL	-	ACCENT WALLS - COLOR TO MATCH PANTONE 2617		
PT-3	PAINT	BENJAMIN MOORE	#OC-66	SNOW WHITE	FLAT FINISH	-	CEILING PAINT - TYP		
PLAM1	COUNTER PLAM	NEVAMAR	EASY ELEGANCE	VA5002T	-	-	-	55-70	95-130
PLAM2	CABINET PLAM	NEVAMAR	NEUTRAL GRAY	S4012T	-	-	-	55-70	95-130
PLAM1	BACKSPLASH	NEVAMAR	EASY ELEGANCE	VA5002T	-	-	-	55-70	95-130

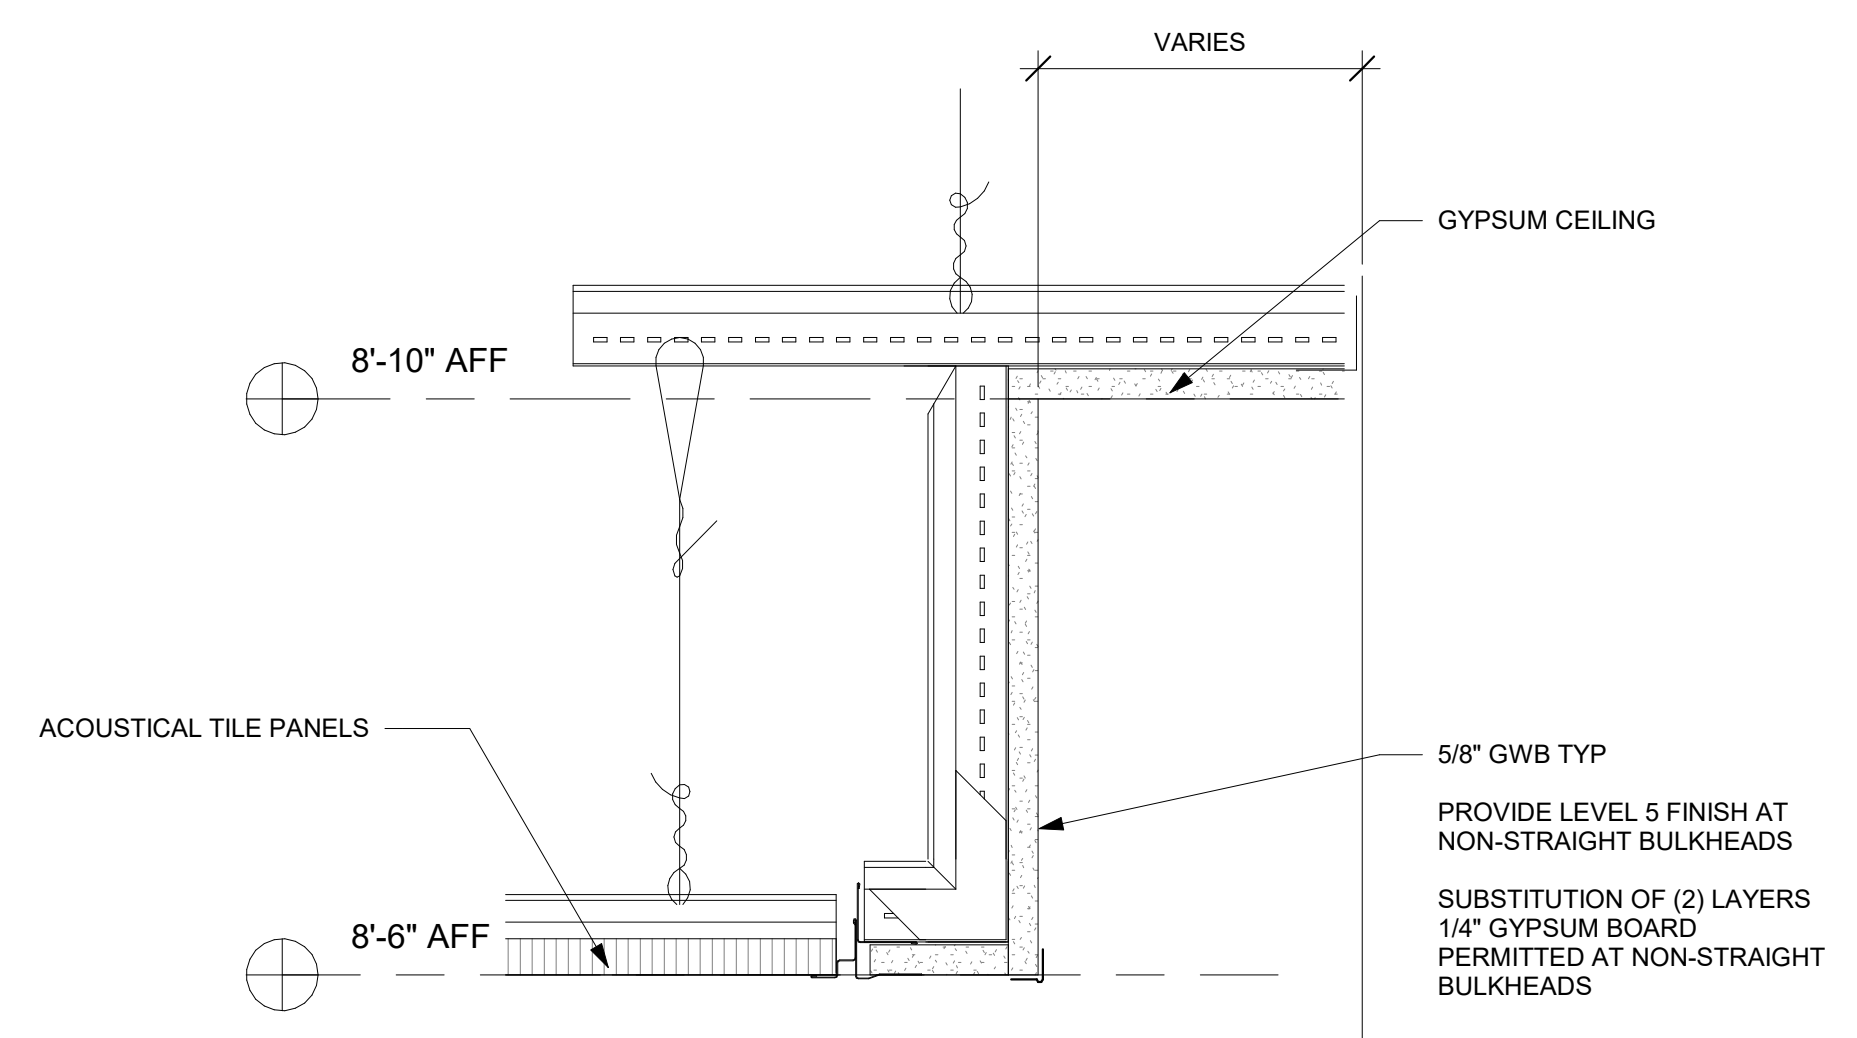


5 TRANSITION DETAIL - GWB SOFFIT
 3" = 1'-0" REFERRED FROM: A112

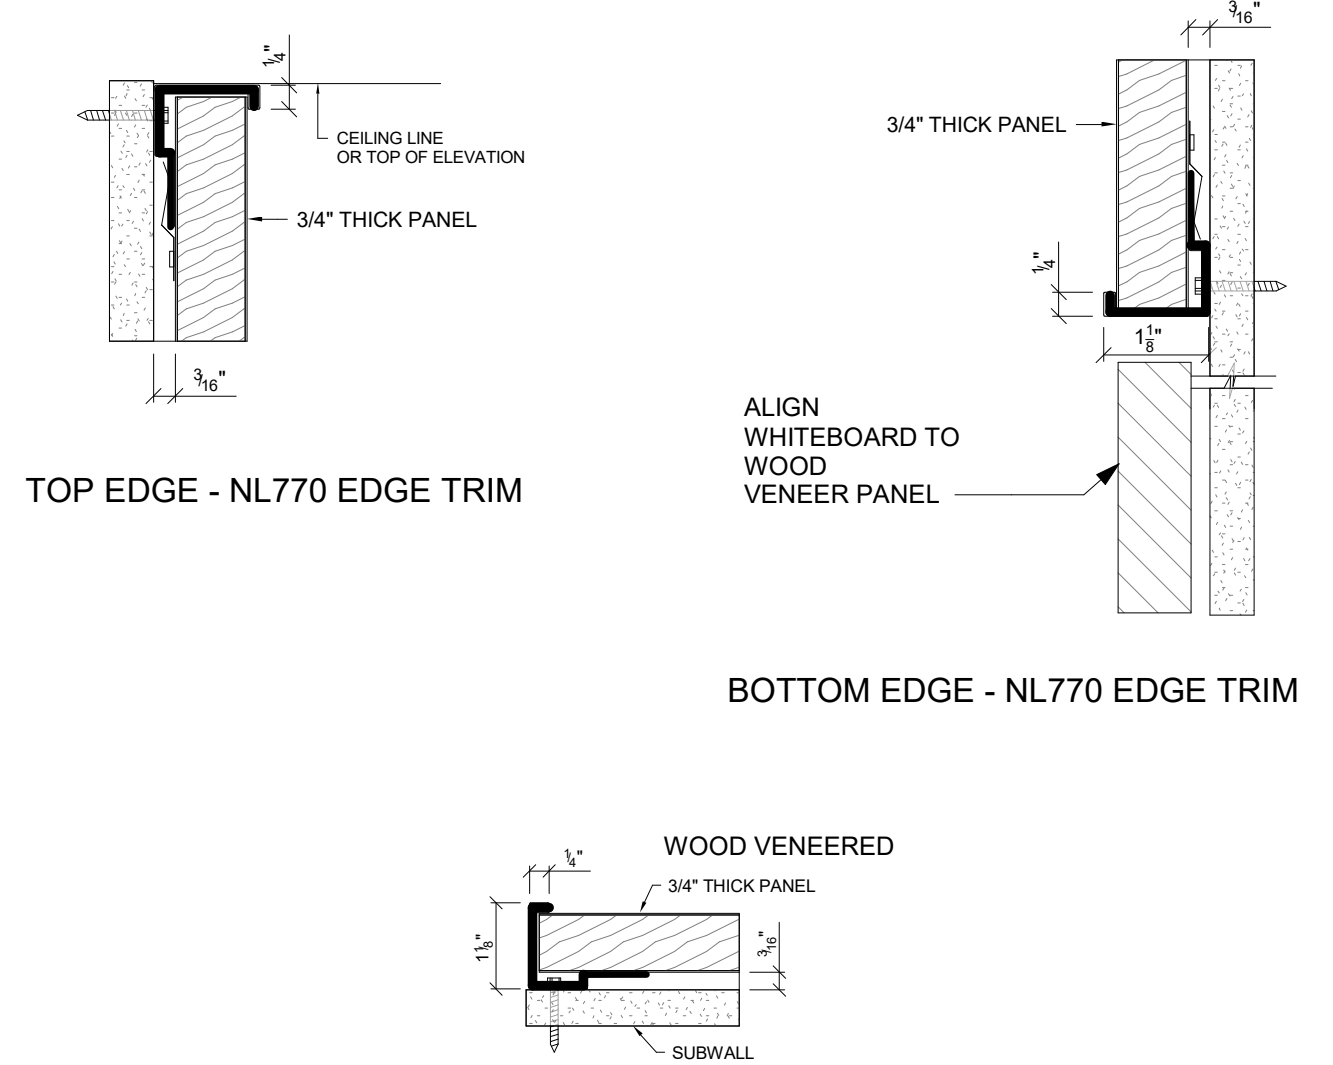


WOOD PANELING SYSTEM DETAILS
 6" = 1'-0"

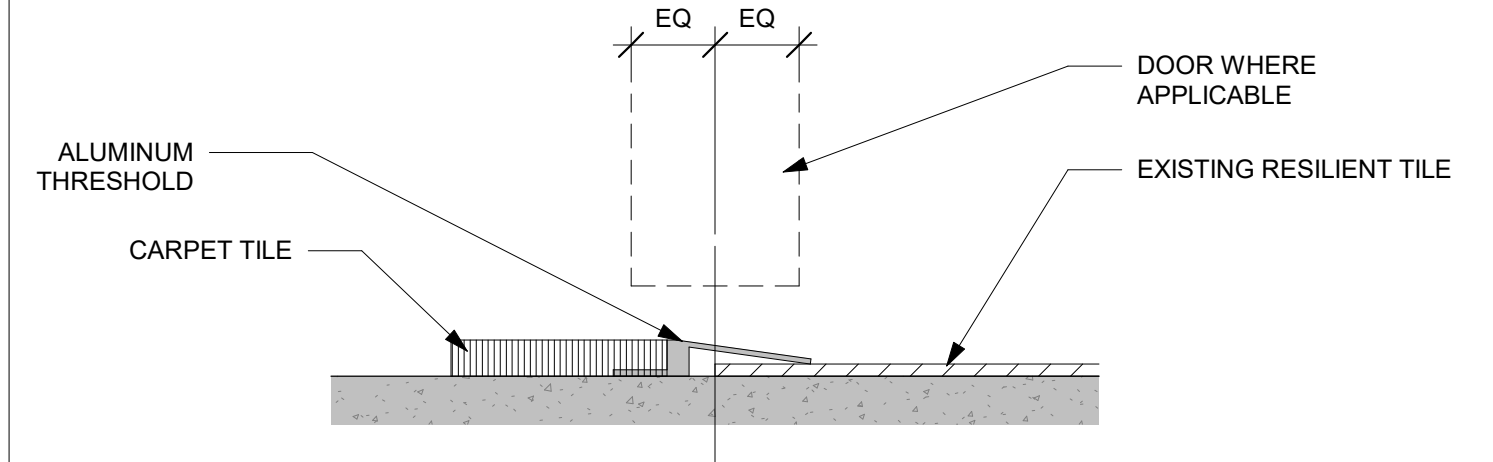


DETAIL - RESILIENT TILE TO CARPET TRANSITION
 6" = 1'-0"

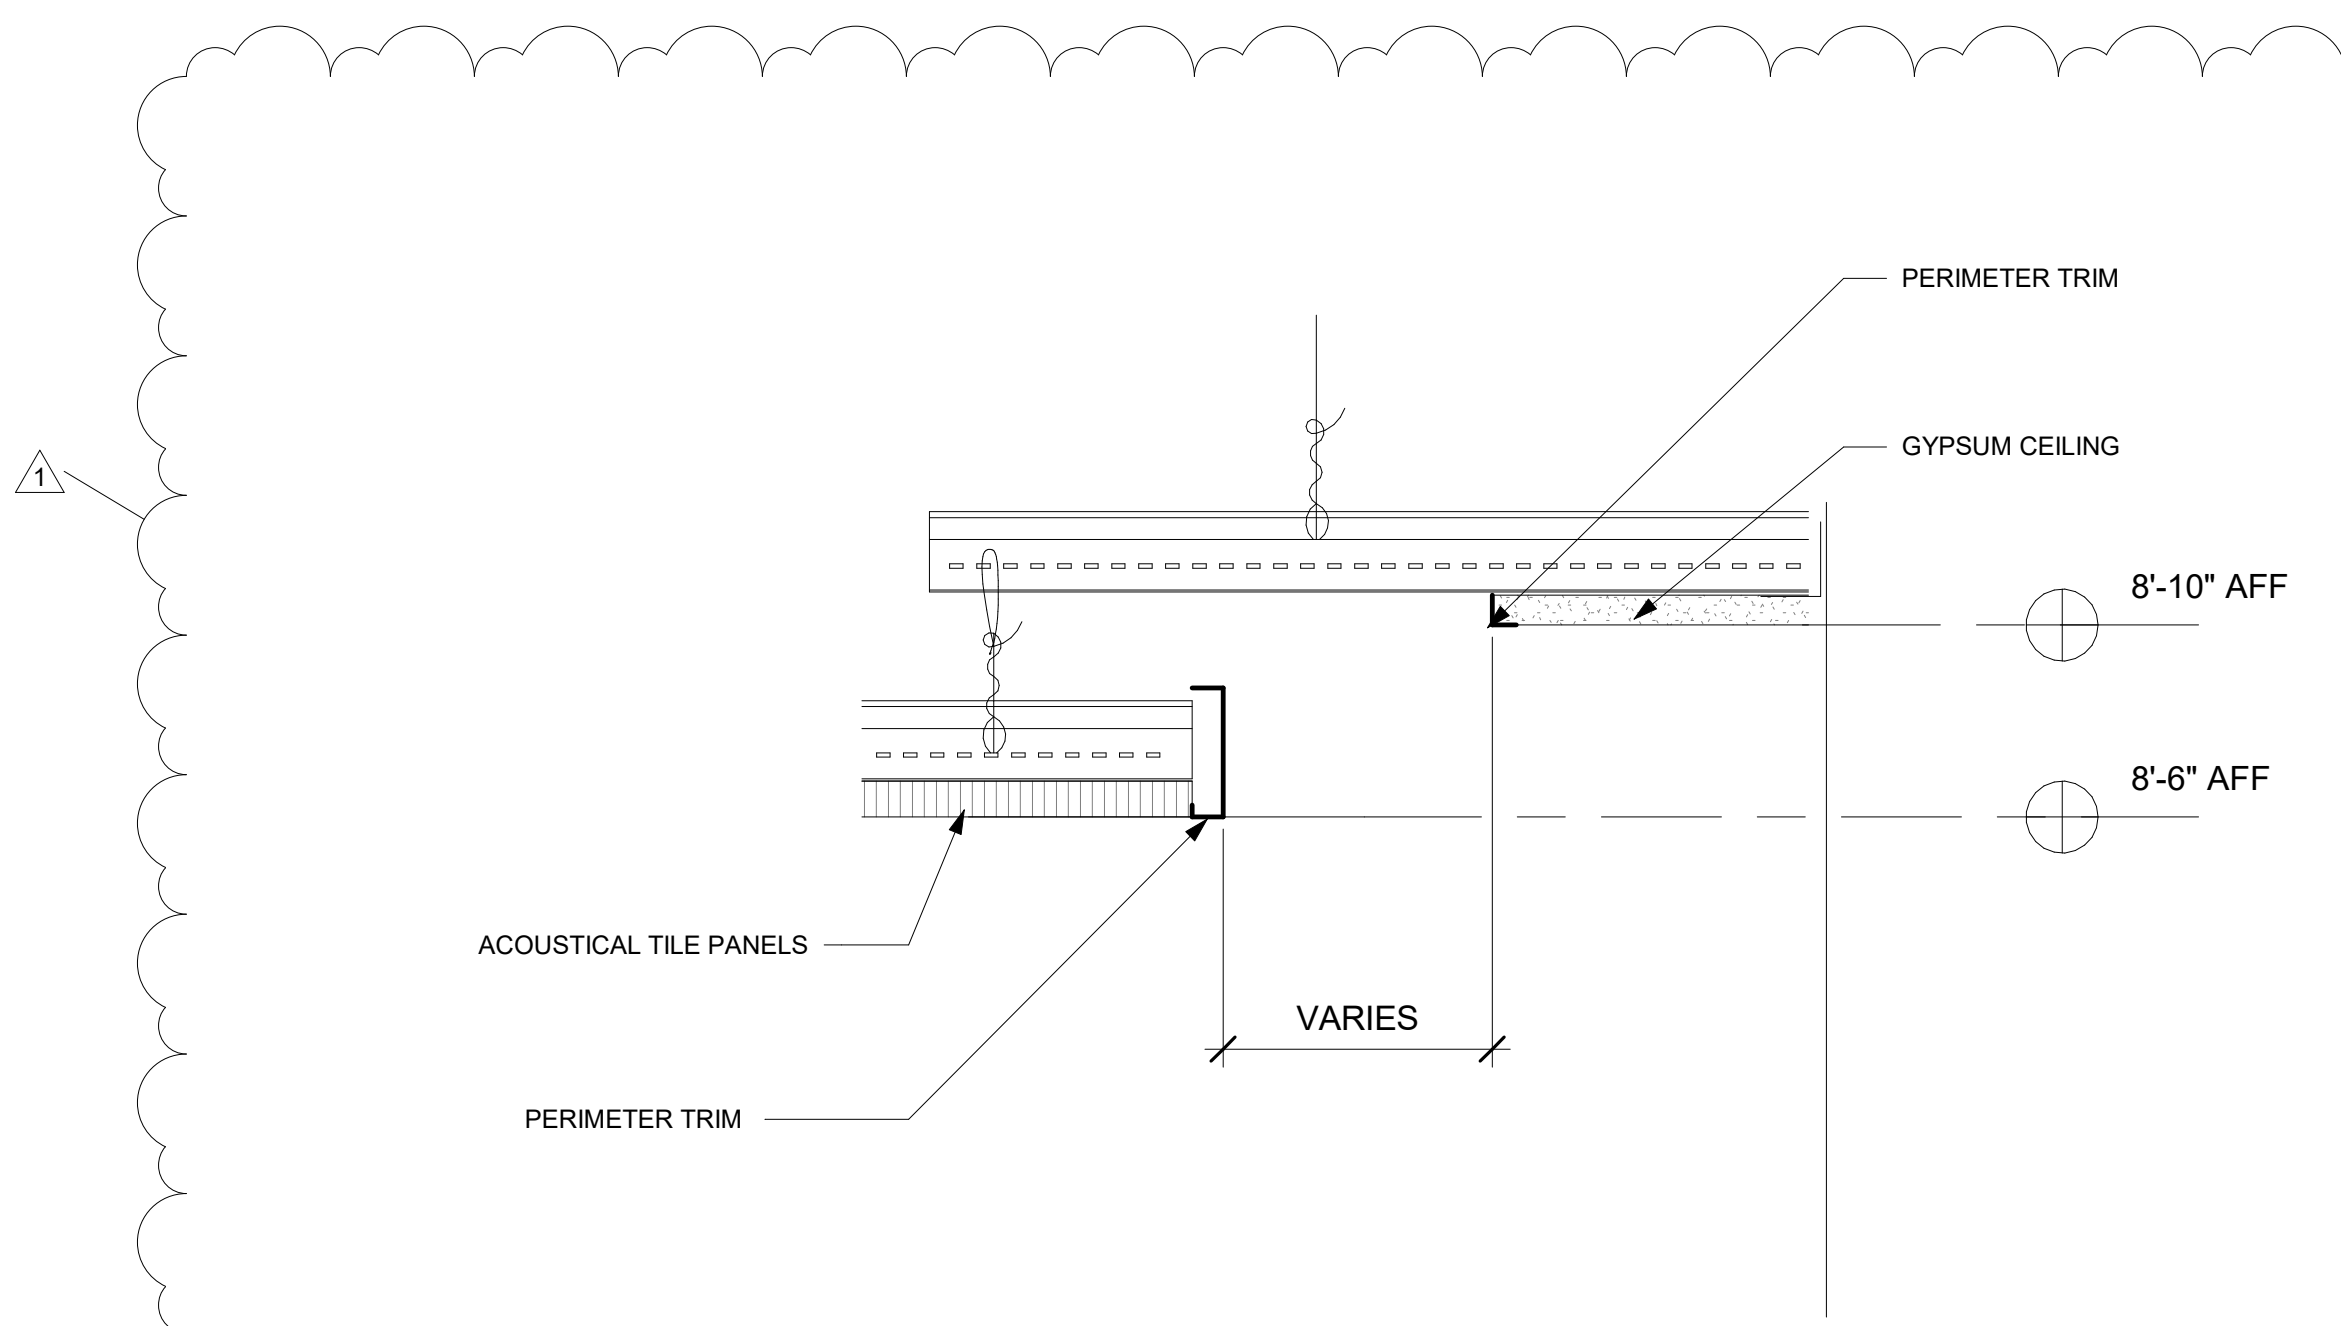

6 TRANSITION DETAIL - GWB SOFFIT
 3" = 1'-0" REFERRED FROM:

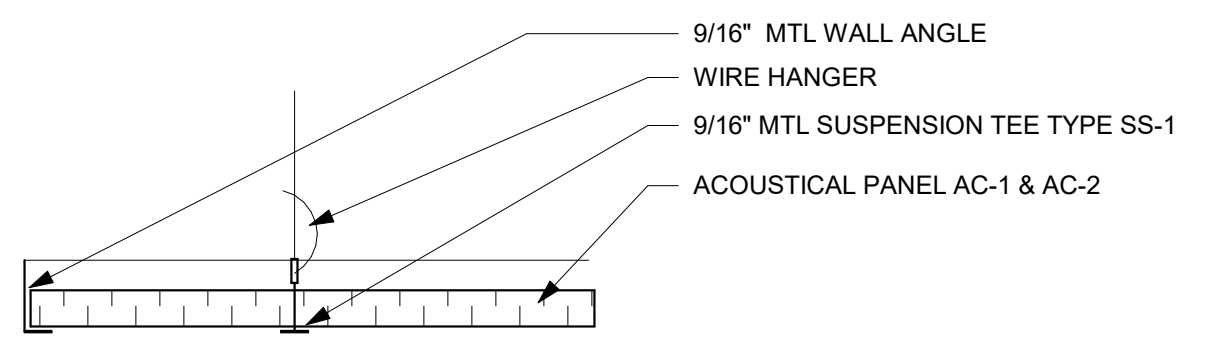

CEILING TYPE C1 AND C2
 3" = 1'-0"

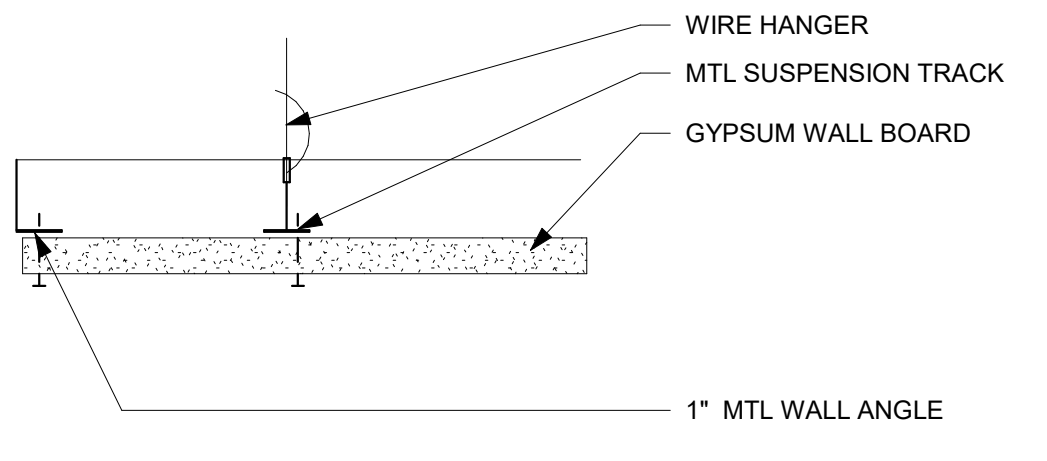

CEILING TYPE C3
 3" = 1'-0"

SEAL:

PROFESSIONAL CERTIFICATION:

PROFESSIONAL CERTIFICATION. I HEREBY CERTIFY THAT THESE DOCUMENTS WERE PREPARED OR APPROVED BY ME, AND THAT I AM A DULY LICENSED PROFESSIONAL ENGINEER UNDER THE LAWS OF THE STATE OF MARYLAND.
 LICENSE NO. 13613
 EXPIRATION DATE: 09/08/2021

ISSUED FOR:

DATE:	DESCRIPTION:
3/6/2020	100% CONSTRUCTION DOCUMENTS
3/25/2020	ADDENDUM #1

PROJECT NO: BKM # 19106.01

SCALE: AS NOTED

DRAWN BY: NM

CHECKED BY: BO

DATE: 03/06/2020

SHEET TITLE: FINISH SCHEDULE AND DETAILS

DRAWING NO:

A607

BKM# 19106.01



ROOM NAME LIST	
001	EXISTING CORRIDOR
001A	CLOSET
001B	MECH
001C	ELEC
001D	MENS
001E	WOMENS
002	TEMPORARY SUITE
002A	MECH ROOM
002C	ELEVATOR MACHINE ROOM
1E1	ELEVATOR 1
1E2	ELEVATOR 2
1SA	STAIR 1

bkm
 Burdette, Koehler, Murphy & Associates, Inc.
 Mechanical / Electrical Engineers
 6300 Star Hill Lane, Suite 400 | Baltimore, Maryland 21209
 P: 410.323.0920 | www.bkma.com

MC
 Central Administration
 Office of Facilities
 9221 Corporate Boulevard
 Rockville, MD 20850
 Telephone: 240-567-7363

**MACKLIN TOWER
 BLDG. 206
 MBI FINANCE LAB
 SUITE 100**

QUINN EVANS ARCHITECTS
 Architects
 100 N. Charles Street
 14th Floor
 Baltimore, MD 21201
 410.576.0440
 www.quinnevans.com

A+F ENGINEERS
 Structural Engineers
 1112 16TH STREET NW
 #920
 WASHINGTON, DC 20036
 202.628.1000
 www.af-engineers.com

SEAL:

PROFESSIONAL CERTIFICATION:
 I HEREBY CERTIFY THAT THESE DOCUMENTS WERE PREPARED OR APPROVED BY ME, AND THAT I AM A DULY LICENSED PROFESSIONAL ENGINEER UNDER THE LAWS OF THE STATE OF MARYLAND.
 LICENSE NO. _____
 EXPIRATION DATE: _____

ISSUED FOR:

DATE:	DESCRIPTION:
3/6/2020	100% CONSTRUCTION DOCUMENTS
3/25/2020	ADDENDUM #1

PROJECT NO: BKM # 19106.01

SCALE: AS NOTED

DRAWN BY: CS

CHECKED BY: JMW

DATE: 03/06/2020

SHEET TITLE: GROUND FLOOR PLAN
 DUCTWORK
 NEW WORK

DRAWING NO:
M2.01
 BKM# 19106.01

1 GROUND FLOOR PLAN - DUCTWORK - NEW WORK



SCALE: 1/8" = 1'-0"

GENERAL NOTES:

- REFER TO M001 FOR MECHANICAL LEGEND, ABBREVIATIONS AND GENERAL NOTES.
- SUPPLY AIR DUCTWORK FROM AHU-9 TO TERMINAL UNITS SHALL BE DOUBLE WALL RECTANGULAR DUCT. SEE SPECIFICATIONS FOR ADDITIONAL REQUIREMENTS.
- PROVIDE NEW CONTROL WIRING AS REQUIRED FROM RELOCATED FAN POWERED TERMINAL UNIT TO EXISTING THERMOSTAT.
- REFER TO GENERAL SPRINKLER NOTES ON M0.01 FOR SPRINKLER WORK RELATED TO THIS AREA.

DRAWING NOTES:

- 28"x18" DOUBLE WALL RECTANGULAR SUPPLY AIR DUCTWORK UP TO MBI SUITE ABOVE.
- 30"x18" RETURN AIR DUCTWORK UP TO MBI SUITE ABOVE.
- PROVIDE DOUBLE WALL RECTANGULAR MEDIUM PRESSURE SUPPLY AIR DUCTWORK UP TO TERMINAL UNITS.
- 24"x10" DOUBLE WALL SUPPLY AIR DUCTWORK UP THROUGH EXISTING SHAFT.
- 30"x12" RETURN AIR DUCTWORK UP THROUGH EXISTING SHAFT. PROVIDE 1" SOUND LINING.
- EXISTING FAN POWERED TERMINAL UNIT RELOCATED TO LOCATION INDICATED. PROVIDE NEW HANGING AND SUPPORTS AS REQUIRED.
- 74"x24" OPEN ENDED RETURN AIR DUCTWORK WITH 1/2" ALUMINUM WIRE MECH SCREEN.
- 96"x24" RELIEF AIR LOUVER THROUGH WALL. PROVIDE RUSKIN L375D STATIONARY LOUVER WITH BIRD AND INSECT SCREEN. PROVIDE LOUVER WITH MINIMUM 45% FREE AREA. COORDINATE FINAL LOUVER COLOR WITH ARCHITECT.
- EXISTING CEILING MOUNTED AIR DEVICE. RE-INSTALL AIR DEVICE IN LOCATION INDICATED. TYPICAL.
- MODIFY EXISTING SPRINKLER PIPING AS REQUIRED THROUGHOUT PROJECT AREA TO ACCOMMODATE NEW WORK. ALL SPRINKLER PIPING SHALL BE MODIFIED IN ACCORDANCE WITH NFPA 13 TO PROVIDE COMPLETE COVERAGE.
- ROUTE NEW RETURN AIR DUCTWORK TIGHT TO STRUCTURE OVER EXISTING HVAC AND DOMESTIC WATER PIPING.
- CONTRACTOR SHALL PROVIDE TEMPORARY HEATING AND COOLING UNIT(S) TO SERVE MBI SUITE ABOVE AS REQUIRED. SEE GENERAL NOTES ON M0.01 FOR ADDITIONAL REQUIREMENTS. PROVIDE TEMPORARY FLEXIBLE DUCTWORK TO SERVE 28x18 SUPPLY AIR DUCTWORK AND 30x18 RETURN AIR DUCTWORK UP TO MBI SUITE. EXTEND TEMPORARY FLEXIBLE DUCTWORK TO 60x16 RELIEF AIR DUCTWORK TO PROVIDE TEMPORARY VENTILATION UNTIL INSTALLATION OF AHU-9 IS COMPLETE.

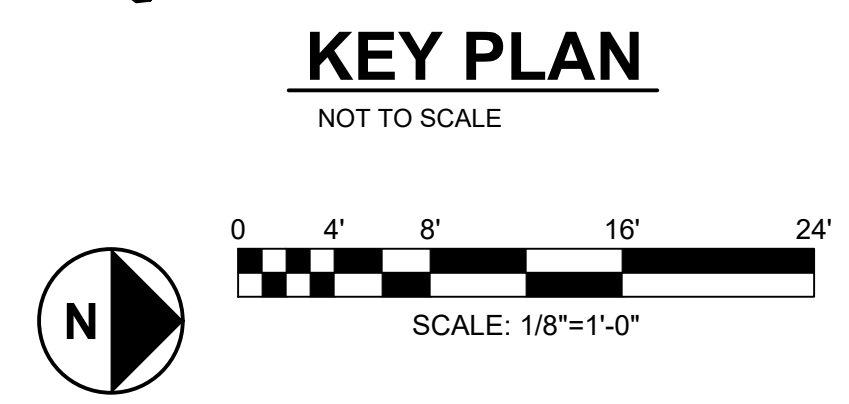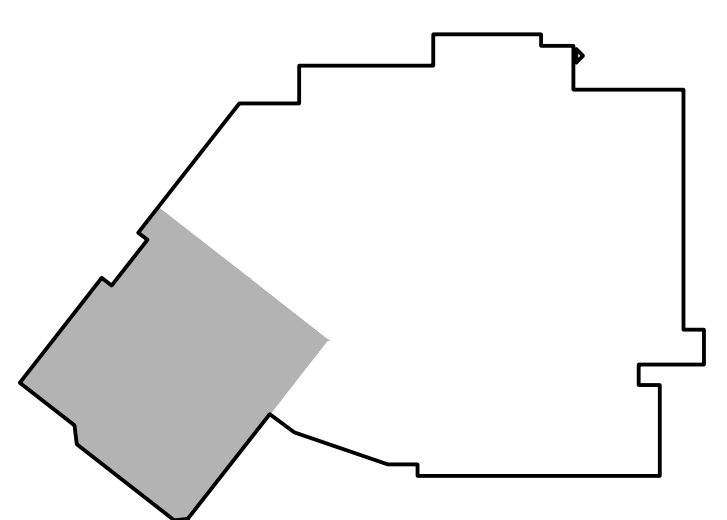

PLOTTED BY: James Weever | 3/24/2020 11:41 AM
 ARL-G:\19106.01\Drawings\Acad\MM201_GFN_FLR_FLN

ROOM NAME LIST	
1	CONFERENCE ROOM
2	OFFICE
3	OFFICE
4	FINANCE LAB/CLASSROOM
5	LOBBY/RECEPTION
6	LOBBY ENTRANCE

bkm
 Burdette, Koehler, Murphy & Associates, Inc.
 Mechanical / Electrical Engineers
 6300 Star Hill Lane, Suite 400 | Baltimore, Maryland 21209
 P: 410.576.0440 | www.bkma.com

PROJECT NAME:
Montgomery College



Central Administration
 Office of Facilities
 9221 Corporate Boulevard
 Rockville, MD 20850
 Telephone: 240-567-7363

**MACKLIN TOWER
 BLDG. 206
 MBI FINANCE LAB
 SUITE 100**

QUINN EVANS ARCHITECTS

Architects
 100 N. Charles Street
 14th Floor
 Baltimore, MD 21201
 410.576.0440
 www.quinnevans.com

A+F ENGINEERS

Structural Engineers
 1112 16TH STREET NW
 #820
 WASHINGTON, DC 20036
 202.628.1600
 www.af-engineers.com

SEAL:

PROFESSIONAL CERTIFICATION:
 I HEREBY CERTIFY THAT THESE DOCUMENTS WERE PREPARED OR APPROVED BY ME, AND THAT I AM A DULY LICENSED PROFESSIONAL ENGINEER UNDER THE LAWS OF THE STATE OF MARYLAND.
 LICENSE NO. _____
 EXPIRATION DATE: _____

ISSUED FOR:

DATE:	DESCRIPTION:
3/6/2020	100% CONSTRUCTION DOCUMENTS
3/25/2020	ADDENDUM #1

PROJECT NO: BKM # 19106.01

SCALE: AS NOTED

DRAWN BY: CS
 CHECKED BY: JMW


DATE: 03/06/2020

SHEET TITLE: FIRST FLOOR PLAN
 MECHANICAL
 NEW WORK

DRAWING NO:

M2.02

BKM# 19106.01

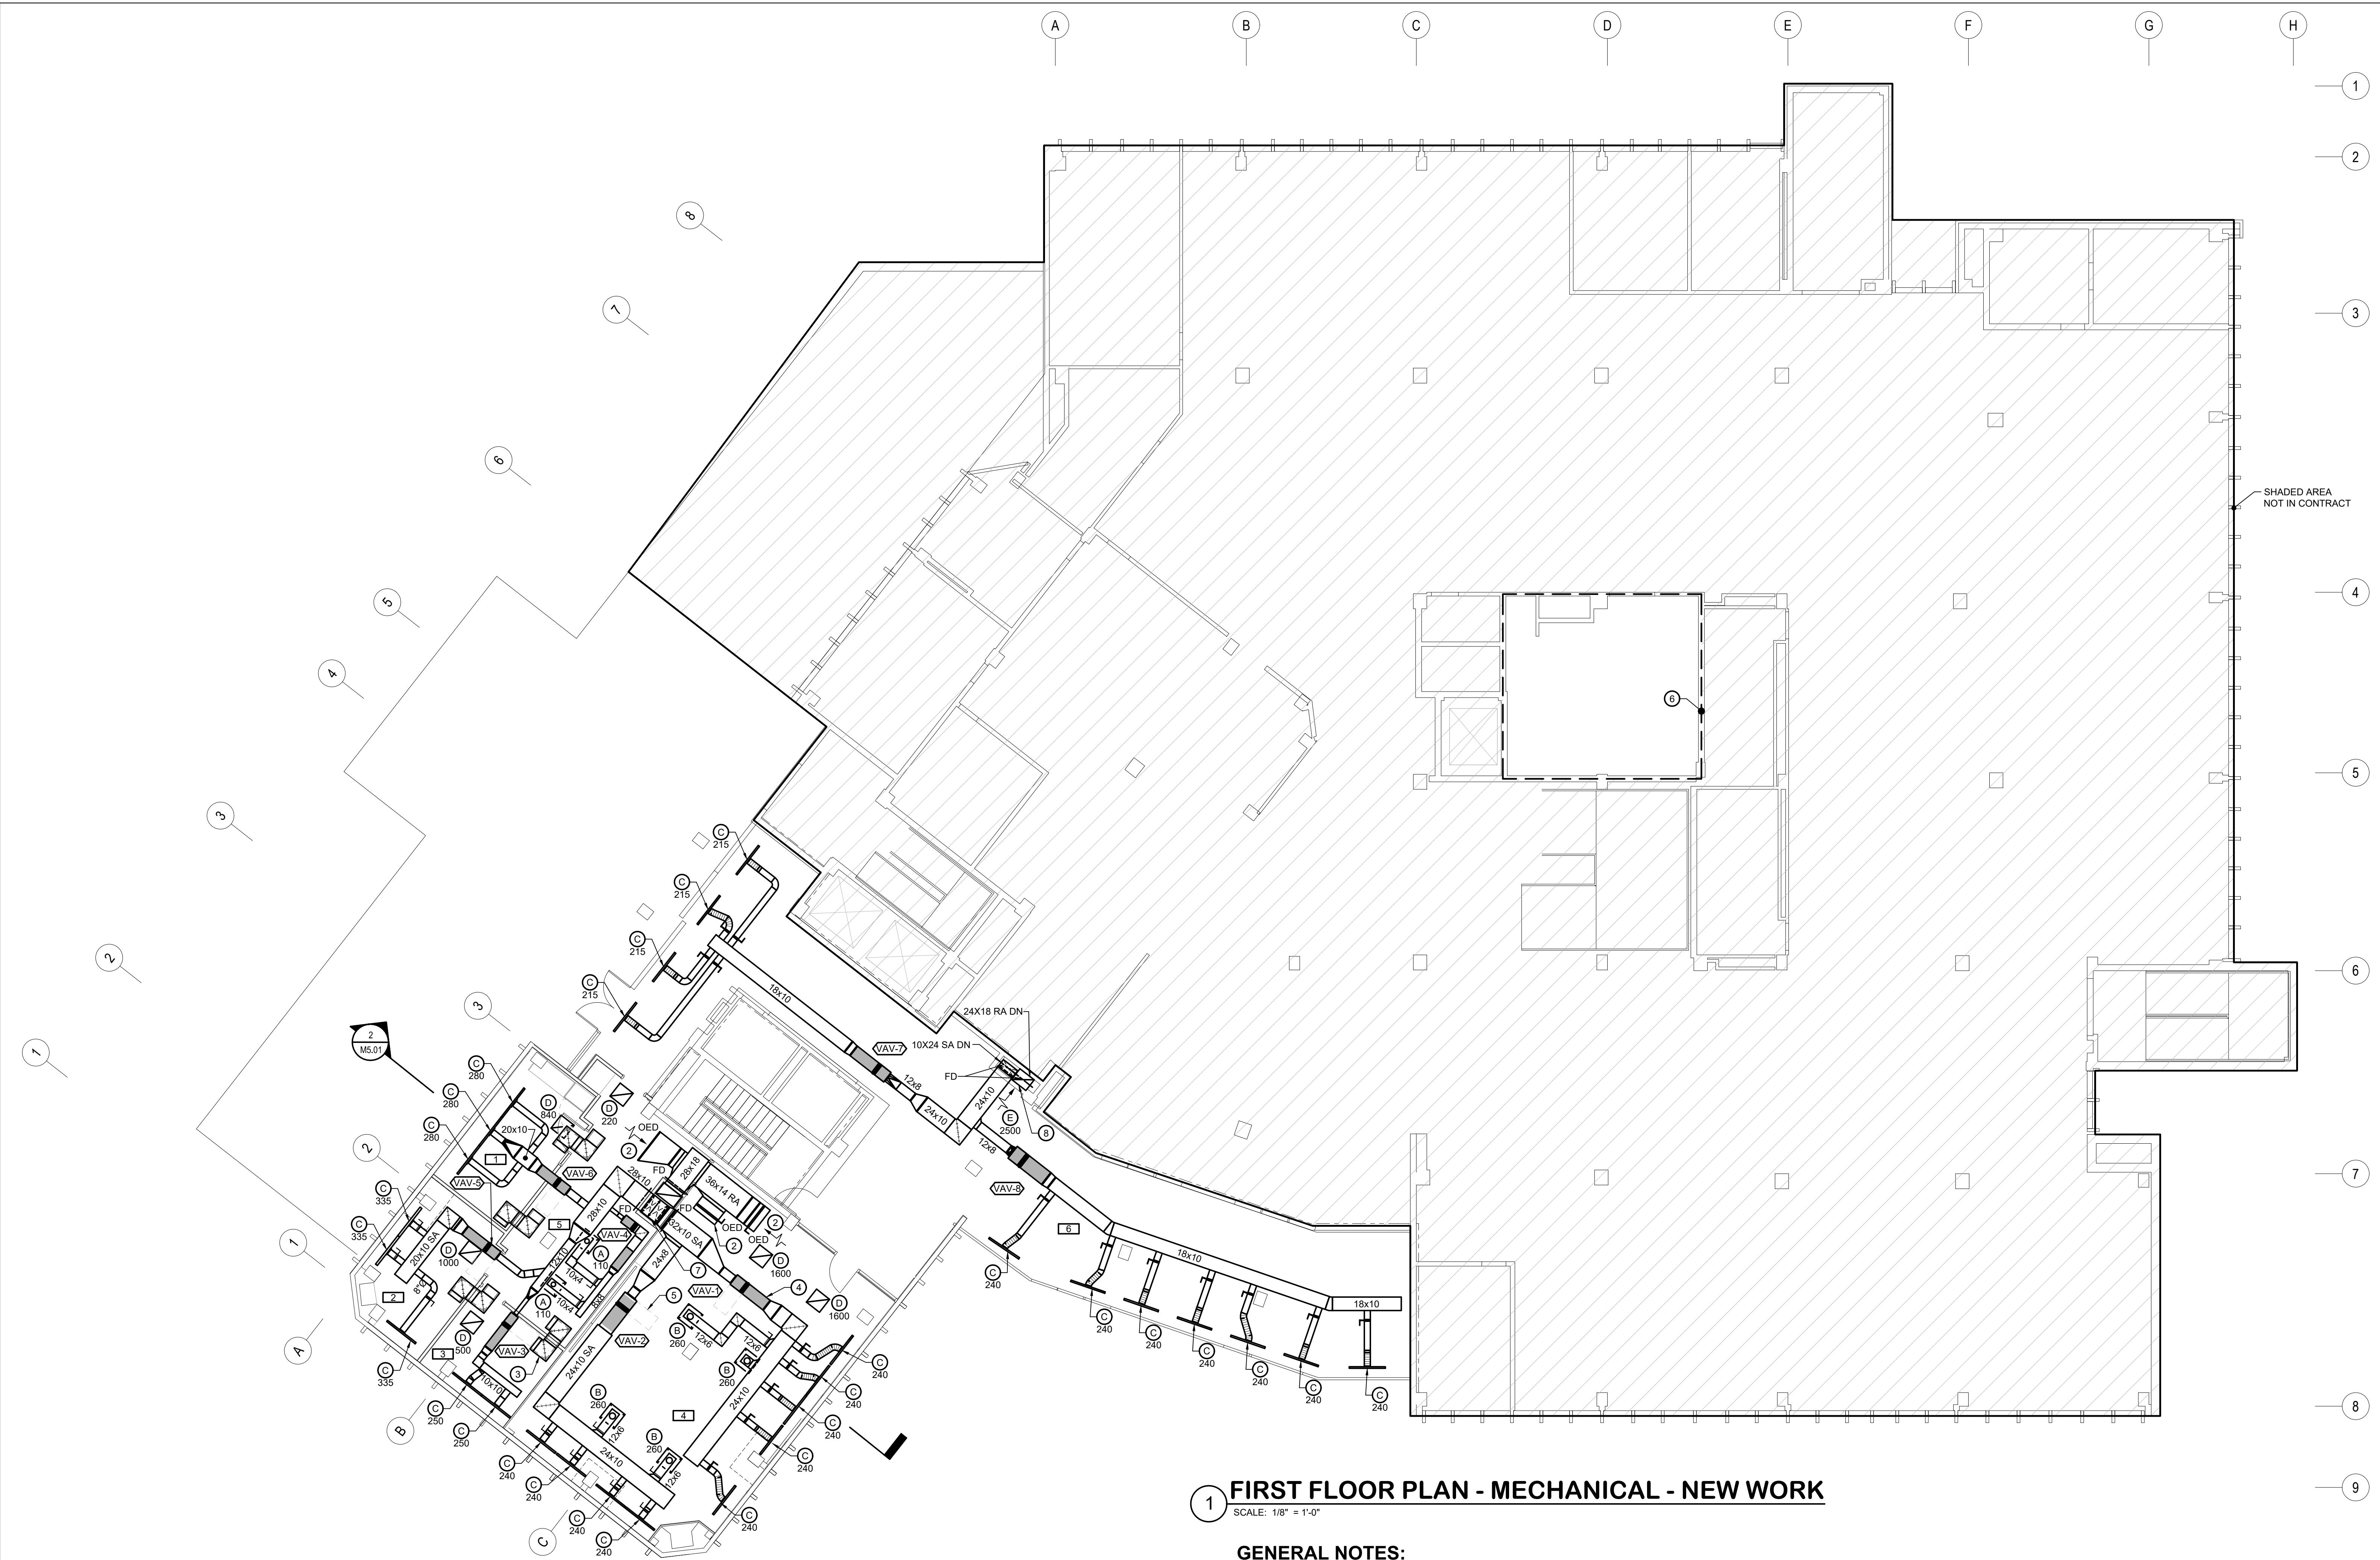


1 FIRST FLOOR PLAN - MECHANICAL - NEW WORK
 SCALE: 1/8" = 1'-0"

GENERAL NOTES:

- REFER TO M0.01 FOR MECHANICAL LEGEND, ABBREVIATIONS AND GENERAL NOTES.
- CONTRACTOR SHALL PROVIDE FULLY COORDINATED DRAWINGS PRIOR TO INSTALLATION OF DUCTWORK.
- REFER TO P2.01 FOR FIRE PROTECTION REQUIREMENTS RELATED TO THIS AREA.
- CONTRACTOR SHALL INSTALL DUCT TIGHT TO THE BOTTOM OF STRUCTURE UNLESS NOTED OTHERWISE.
- SUPPLY AIR DUCTWORK UPSTREAM OF TERMINAL UNITS SHALL BE DOUBLE WALL RECTANGULAR DUCT. SEE SPECIFICATIONS FOR ADDITIONAL REQUIREMENTS.
- SEE M3.02 FOR THERMOSTAT LOCATIONS.
- CONTRACTOR SHALL PROVIDE TEMPORARY HEATING AND COOLING AS REQUIRED TO THE MBI SUITE. SEE GENERAL NOTES ON M0.01 FOR ADDITIONAL REQUIREMENTS.

DRAWING NOTES:

- 36"x10" OPEN ENDED DUCT WITH 1/2" ALUMINUM WIRE MESH SCREEN. BALANCE TO 1,600 CFM.
- 48"x12" OPEN ENDED DUCT WITH 1/2" ALUMINUM WIRE MESH SCREEN. BALANCE TO 3,500 CFM.
- 20"x8" TRANSFER AIR DUCTWORK. PROVIDE TRANSFER AIR DUCT WITH 1" SOUND LINING. TYPICAL OF 4.
- PROVIDE ENGINEERED DUCT SILENCER TO ACHIEVE NC VALUES INDICATED ON THE SCHEDULES. SILENCERS SHALL HAVE A MAXIMUM HEIGHT OF 10" AND BE PROVIDED BY RUSKIN ON VIBRO-ACOUSTICS. TYPICAL OF 8.
- SINGLE DUCT TERMINAL UNIT WITH HEATING WATER REHEAT COIL. PROVIDE A MINIMUM 36" CLEARANCE IN FRONT OF TERMINAL UNIT CONTROLLER. TYPICAL OF 8.
- REFER TO DRAWING M6.01 AND M6.02 FOR ADD ALTERNATE WORK RELATED TO THIS AREA.
- 18x28 SUPPLY AIR DUCTWORK AND 10x28 SUPPLY AIR DUCTWORK TRANSITION DOWN TO AN 18x28 SUPPLY AIR DUCT DOWN TO GROUND FLOOR.
- 24x10 SUPPLY AIR DUCTWORK AND 24x18 RETURN AIR DUCTWORK DOWN THROUGH EXISTING SHAFT. PROVIDE FIRE DAMPER AT EXISTING FLOOR OPENING.

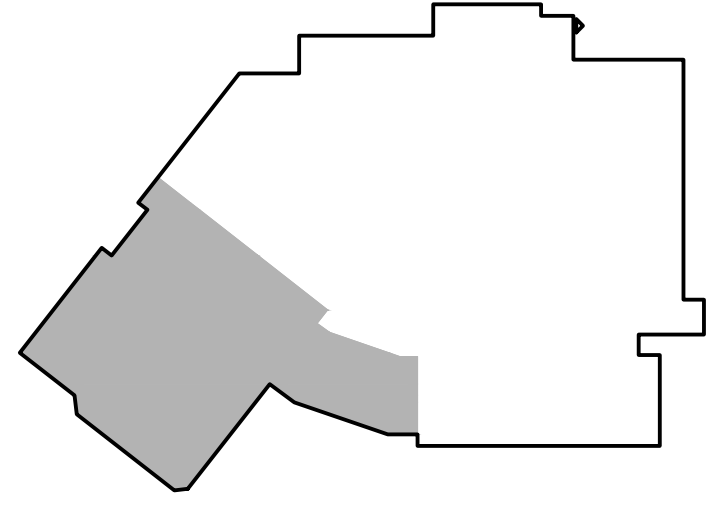

KEY PLAN
 NOT TO SCALE



ARL_G:\19106.01\Drawings\Acad\MM202_1ST FLR FLN

Printed By: James Weaver | 3/23/2020 | 1:25 PM

ROOM NAME LIST	
1	CONFERENCE ROOM
2	OFFICE
3	OFFICE
4	FINANCE LAB/CLASSROOM
5	LOBBY/RECEPTION
6	LOBBY ENTRANCE

bkm
 Burdette, Koehler, Murphy & Associates, Inc.
 Mechanical / Electrical Engineers
 6300 Star Hill Lane, Suite 400 | Baltimore, Maryland 21209
 P: 410.323.0920 | www.bkma.com

PROJECT NAME:
Montgomery College



Central Administration
 Office of Facilities
 9221 Corporate Boulevard
 Rockville, MD 20850
 Telephone: 240-567-7363

**MACKLIN TOWER
 BLDG. 206
 MBI FINANCE LAB
 SUITE 100**

QUINN EVANS ARCHITECTS

Architects
 100 N. Charles Street
 14th Floor
 Baltimore, MD 21201
 410.576.0440
 www.quinnevans.com

A+F ENGINEERS

Structural Engineers
 1112 16TH STREET NW
 #920
 WASHINGTON, DC 20036
 202.628.1600
 www.af-engineers.com

SEAL:

PROFESSIONAL CERTIFICATION:
 I HEREBY CERTIFY THAT THESE DOCUMENTS WERE PREPARED OR APPROVED BY ME, AND THAT I AM A DULY LICENSED PROFESSIONAL ENGINEER UNDER THE LAWS OF THE STATE OF MARYLAND.
 LICENSE NO. _____
 EXPIRATION DATE: _____

ISSUED FOR:

DATE:	DESCRIPTION:
3/6/2020	100% CONSTRUCTION DOCUMENTS
3/25/2020	ADDENDUM #1

PROJECT NO: BKM # 19106.01

SCALE: AS NOTED


DRAWN BY: SY

CHECKED BY: JMW

DATE: 03/06/2020

SHEET TITLE: FIRST FLOOR PLAN PLUMBING NEW WORK


DRAWING NO:
P2.01
 BKM# 19106.01

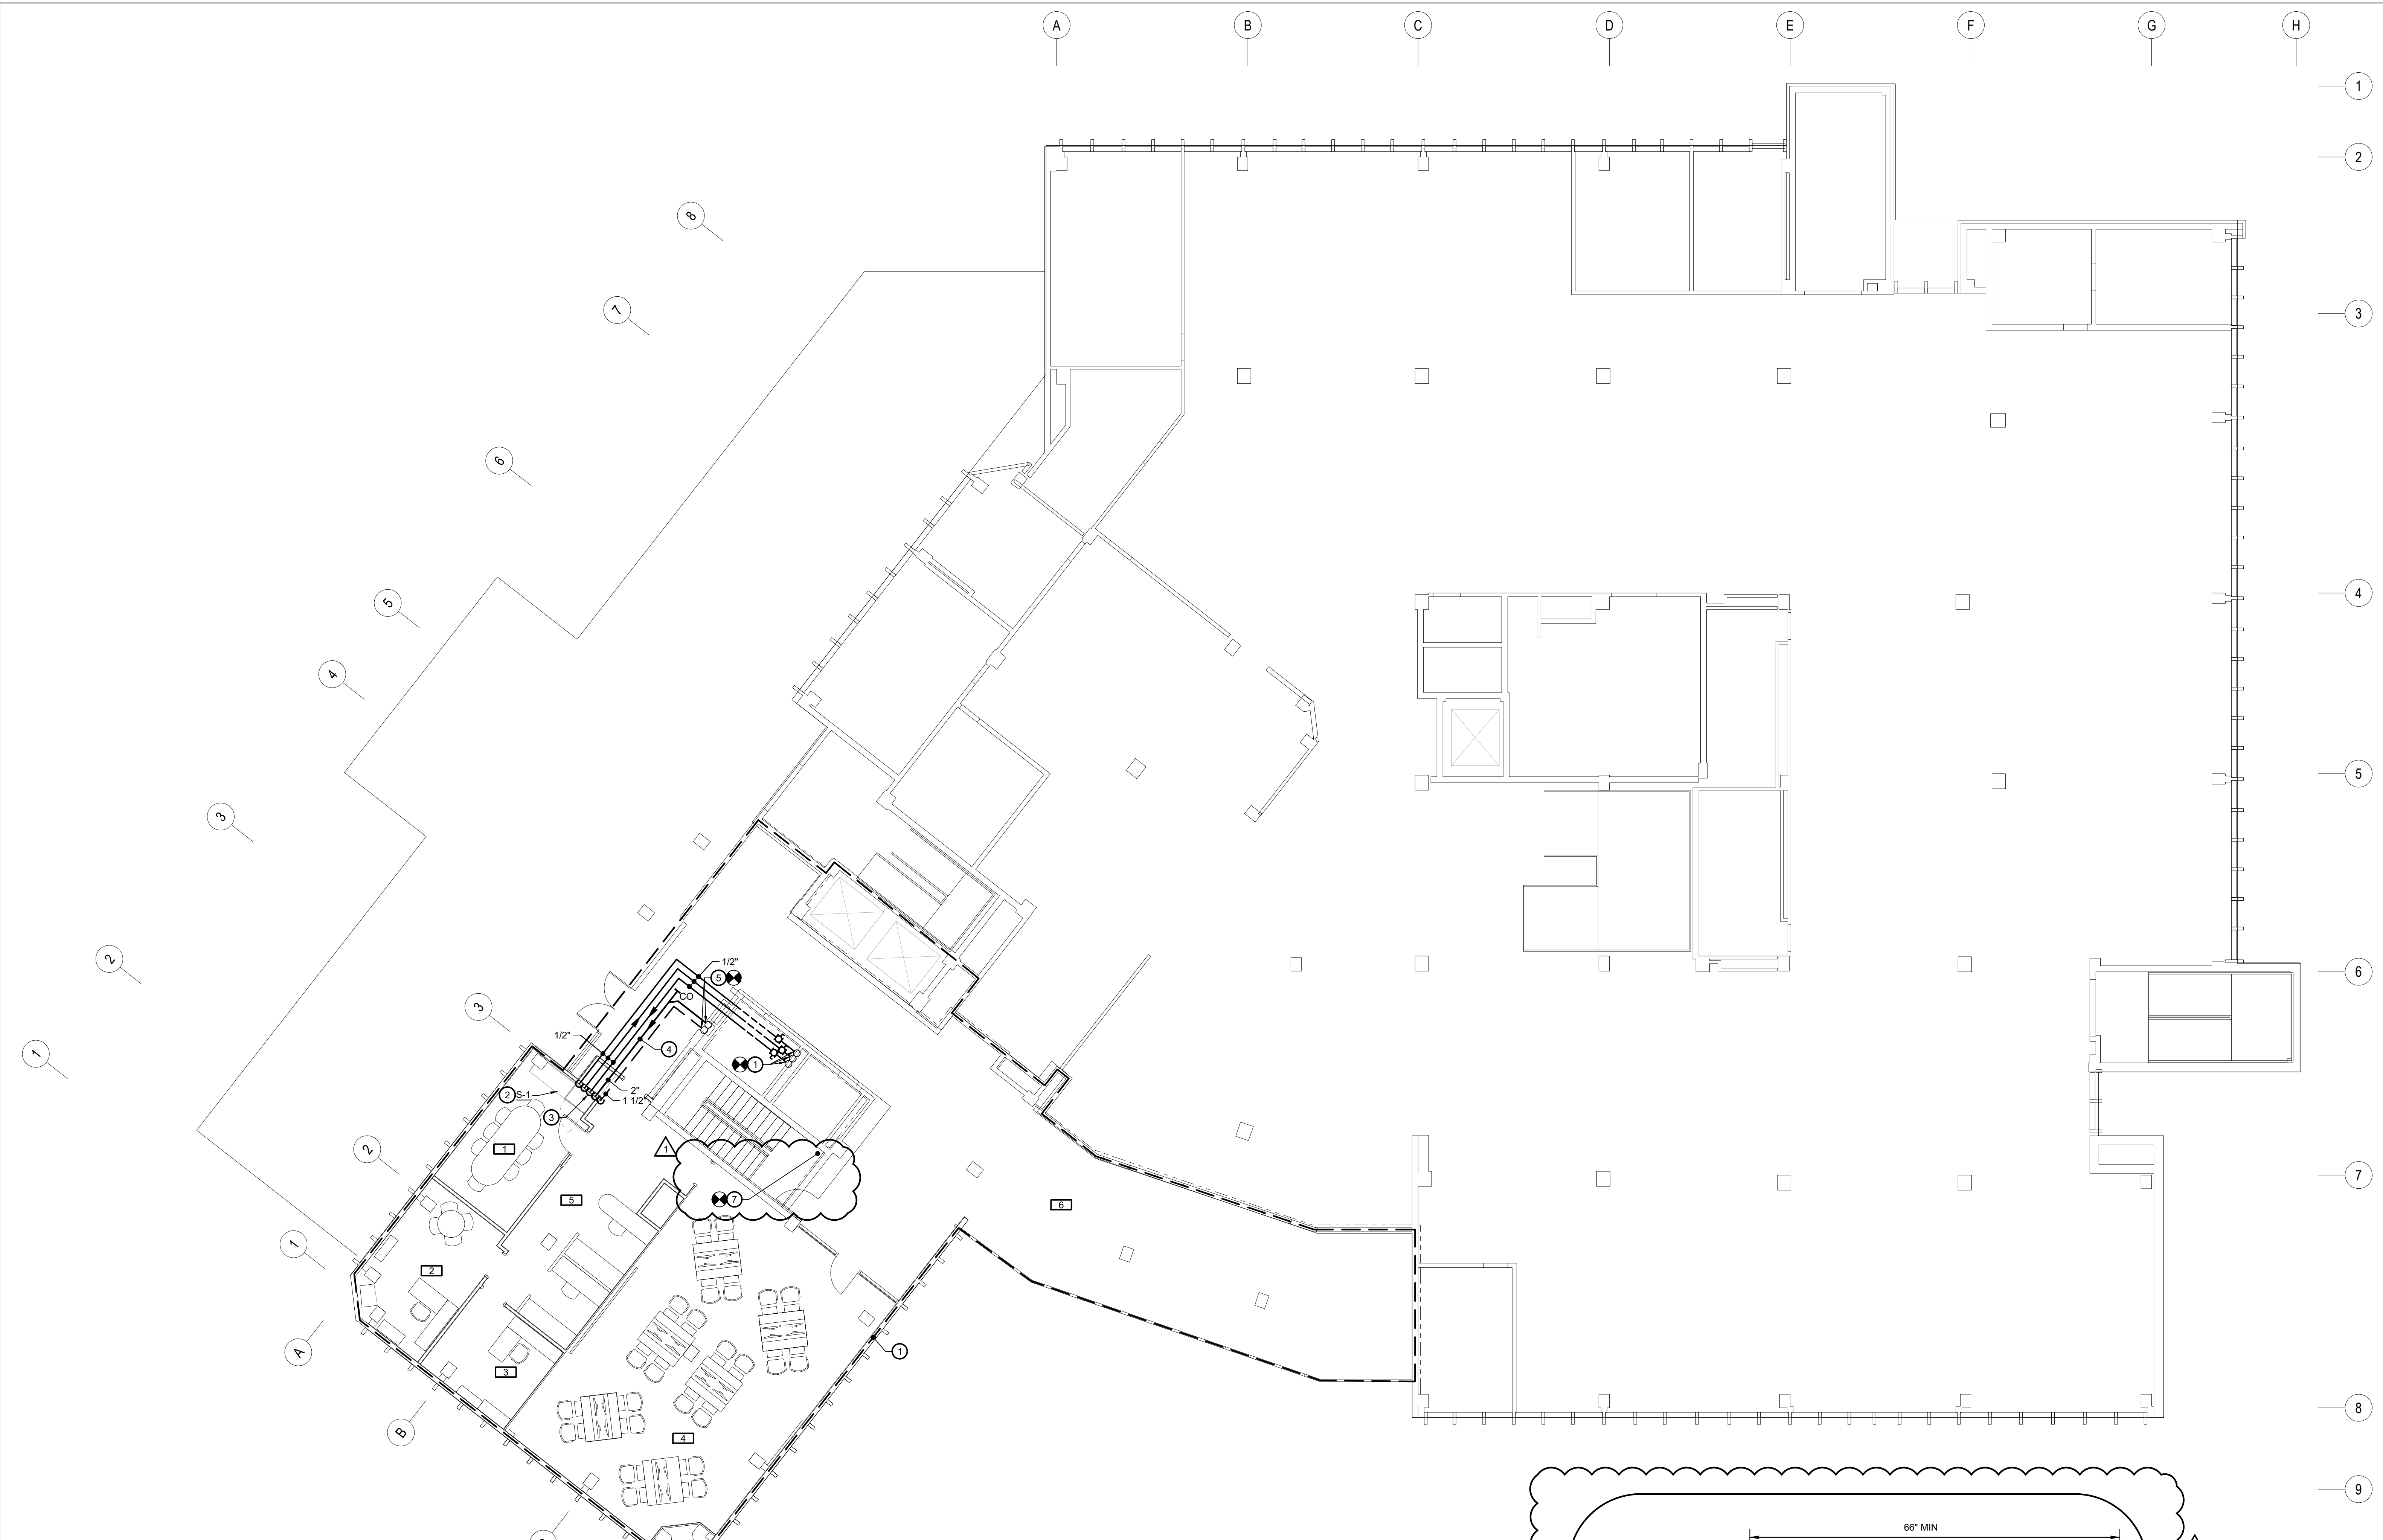


1 FIRST FLOOR PLAN - PLUMBING - NEW WORK
 SCALE: 1/8" = 1'-0"

GENERAL NOTES:
 1. REFER TO M0.01 FOR PLUMBING LEGEND, ABBREVIATIONS AND GENERAL NOTES.

- DRAWING NOTES:**
- EXTEND SPRINKLER PIPING AS REQUIRED TO PROVIDE COMPLETE COVERAGE OR PROJECT AREA PER NFPA 13. PROVIDE NEW SPRINKLER HEADS AND BRANCH PIPING AS REQUIRED. SPRINKLER HEADS SHALL BE RECESSED QUICK-RESPONSE TYPE. COORDINATE SPRINKLER HEAD FINISH WITH OWNER AND ARCHITECT.
 - UNDER MOUNT FINTRY SINK PROVIDE HOUSING AND FINAL CONNECTION. PROVIDE 18"x22" 1/2" GAUGE SINGLE COMPARTMENT SINK WITH 3-HOLE PUNCH. PROVIDE 8" GOOSENECK, 4" WRIST BLADE HANDLE, 8" FAUCET CENTERS, 2.5 GPM AERATOR, CHROME BASKET STRAINER, FLEXIBLE SUPPLIES, TAIL PIECE AND CAST BRASS P-TRAP, ELKAY LUSTERTONE OR EQUIVALENT.
 - 1/2" COLD WATER, 1/2" HOT WATER AND 1" VENT DOWN TO S-1, 2" SANITARY UP TO S-1 FROM FLOOR BELOW. PROVIDE THERMOSTATIC MIXING VALVE AT FIXTURE.
 - 2" SANITARY PIPING ROUTED IN PLENUM BELOW FLOOR. SLOPE SANITARY PIPING TOWARD EXISTING RISER AT 1% SLOPE.
 - 2" SANITARY AND 1" VENT PIPING CONNECTED TO EXISTING SANITARY AND VENT PIPING SERVING EXISTING ELECTRIC WATER COOLER.
 - 1/2" COLD WATER, 1/2" HOT WATER AND 1/2" HOT WATER RECIRCULATION PIPING EXTENDED FROM EXISTING RISER.
 - EXTEND NEW SPRINKLER PIPING FROM EXISTING 4" STAND PIPE RISER. INSTALL SPRINKLER SYSTEM IN ACCORDANCE WITH NFPA 13. PROVIDE FLOW SWITCH, PRESSURE GAUGE AND VICTAULIC TEST MASTER EXTENDED TO EXISTING 2" INSPECTOR'S TEST DRAIN RISER.

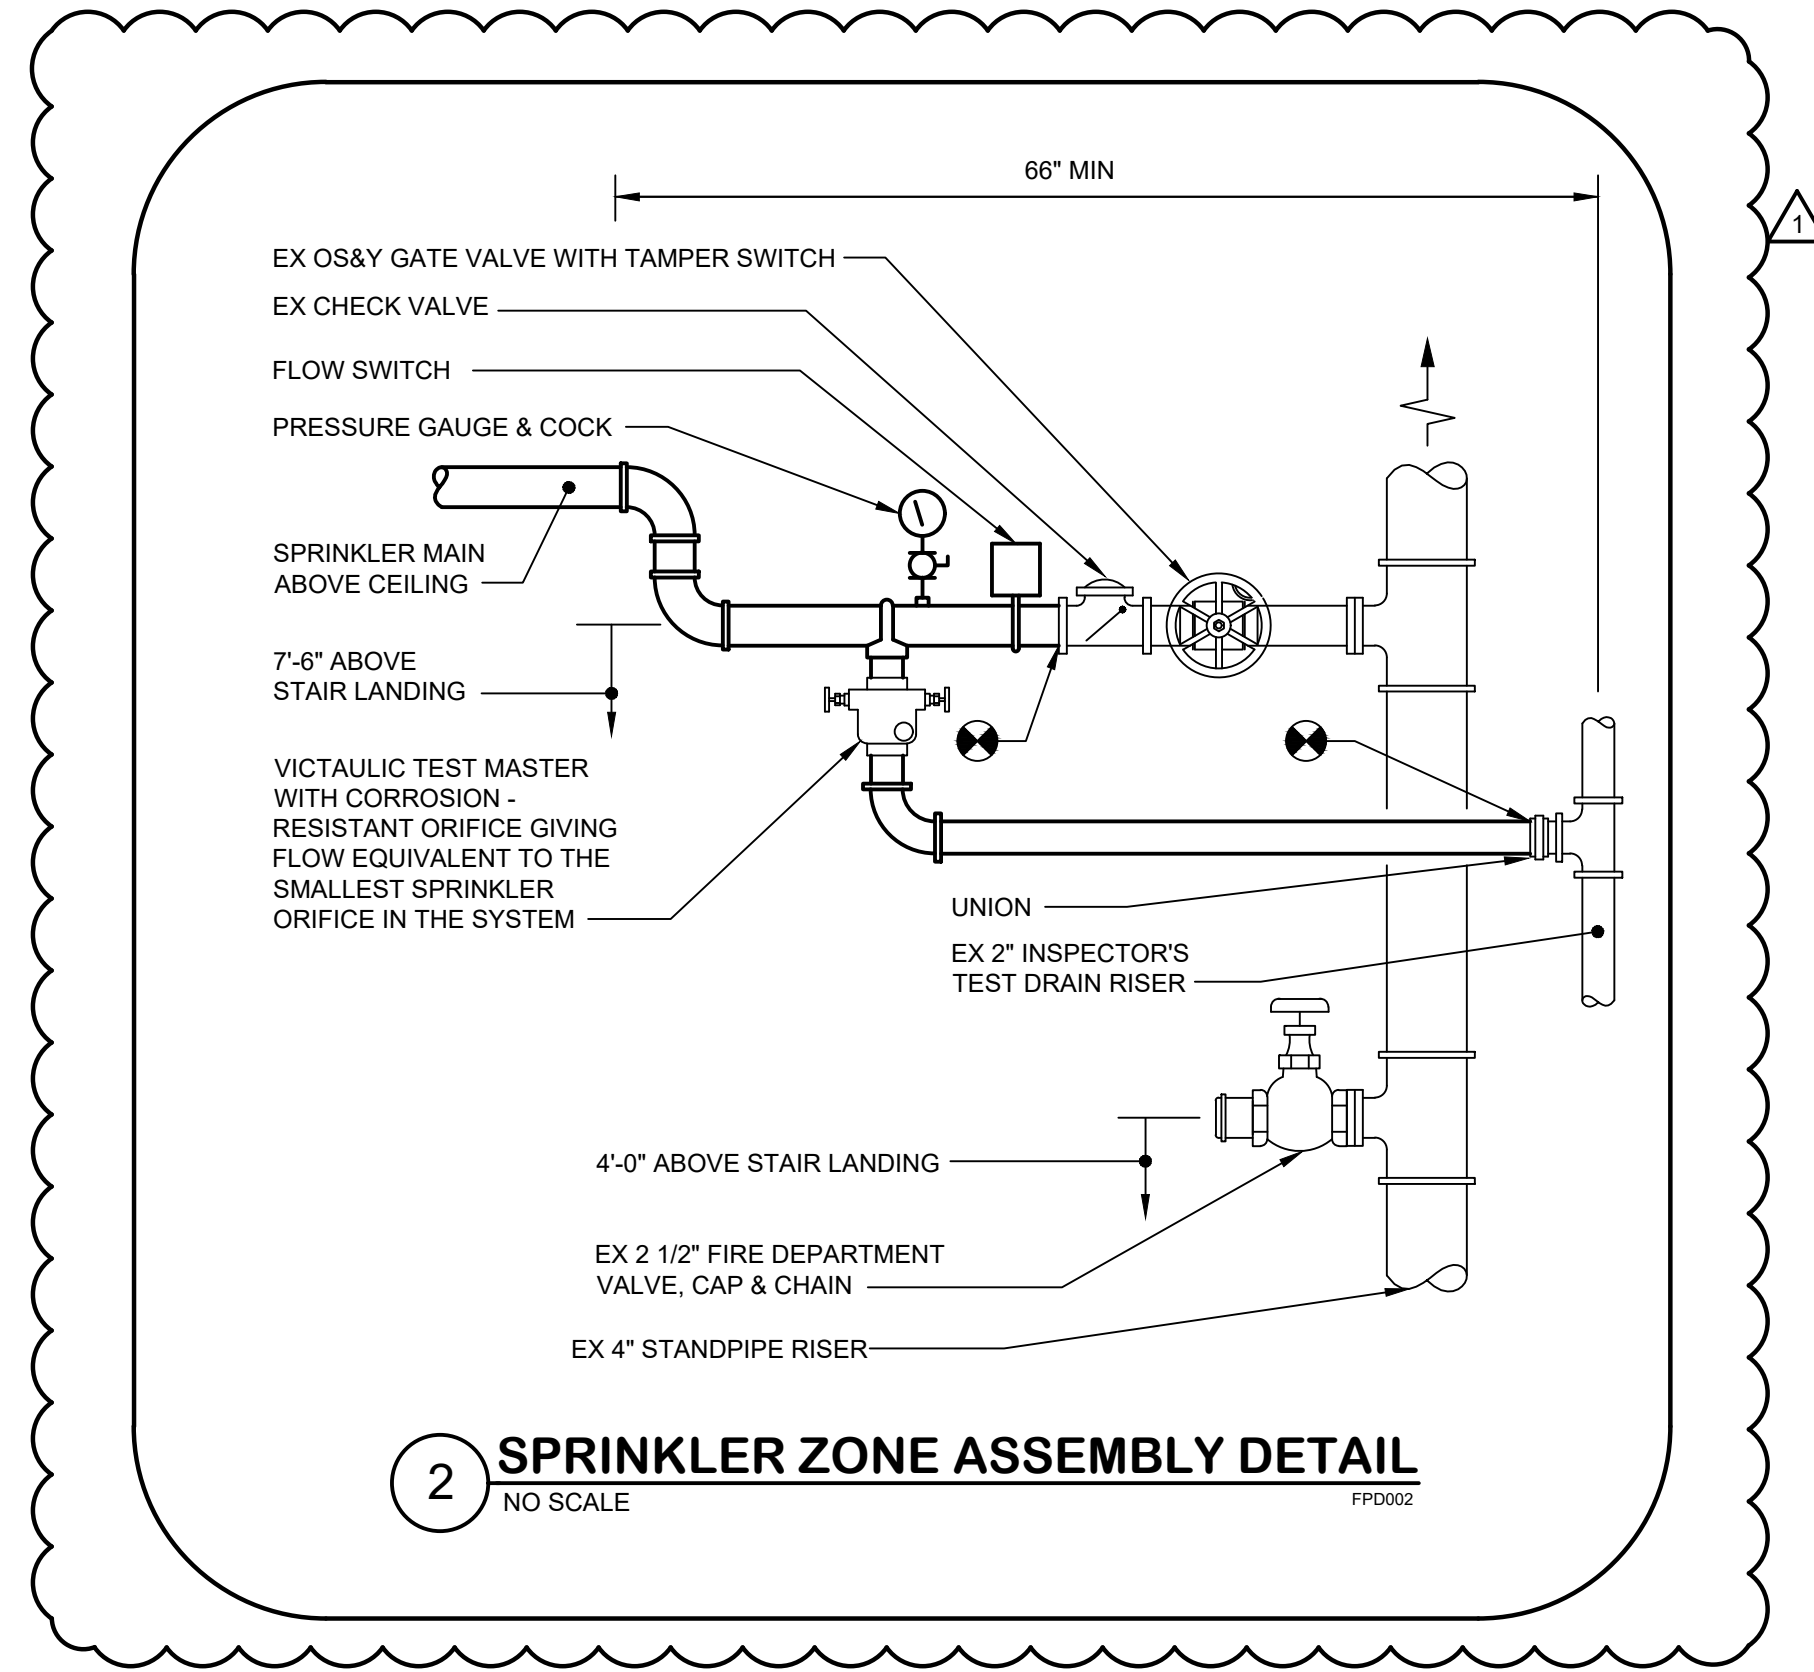

2 SPRINKLER ZONE ASSEMBLY DETAIL
 NO SCALE

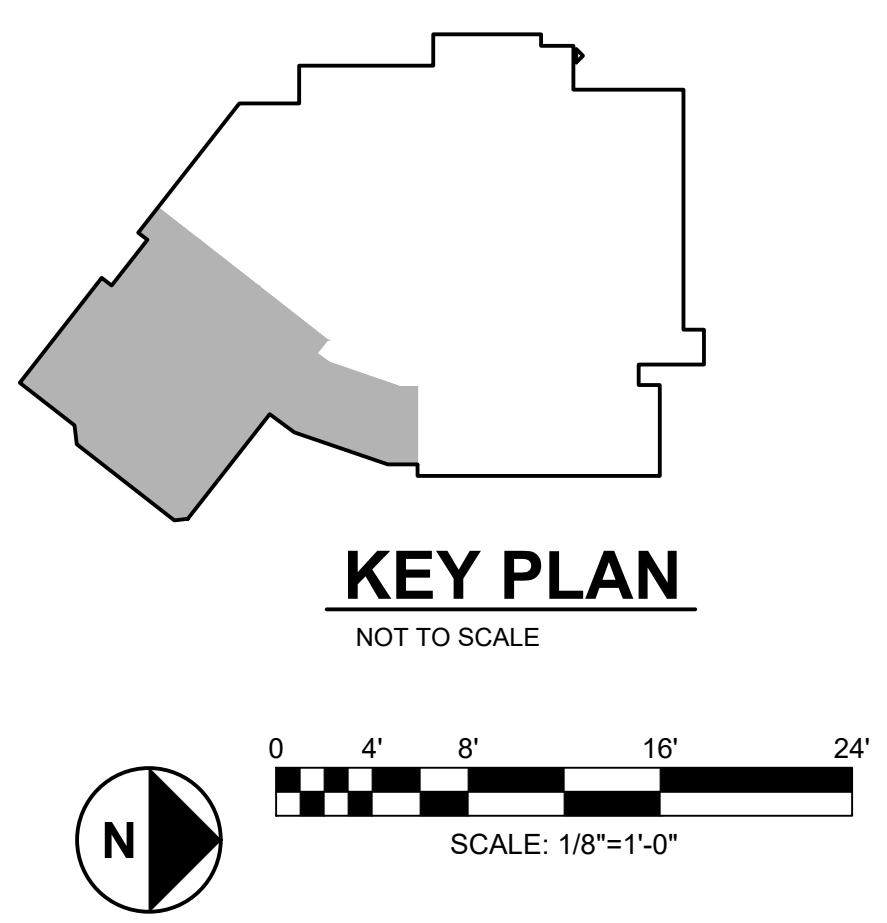

ARL G:\19106.01 Drawings\Acad\PP201 FIRST FLOOR PLAN PLUMBING N
 Plotted By: James Weaver | 3/23/2020 | 1:25 PM

PROJECT NAME:

Montgomery College



Central Administration
 Office of Facilities
 9221 Corporate Boulevard
 Rockville, MD 20850
 Telephone: 240-567-7963

**MACKLIN TOWER
 BLDG. 206
 MBI FINANCE LAB
 SUITE 100**

QUINN EVANS ARCHITECTS

Architects
 100 N. Charles Street
 14th Floor
 Baltimore, MD 21201
 410.576.0440
 www.quinnevans.com

A+F ENGINEERS

Structural Engineers
 1122 16TH STREET NW
 #202
 WASHINGTON, DC 20036
 202.628.1600
 www.af-engineers.com

GENERAL NOTES:

- REFER TO E0.01 FOR ELECTRICAL LEGEND, ABBREVIATIONS AND GENERAL NOTES.
- UNLESS NOTED OTHERWISE, ELECTRICAL ITEMS SHOWN HEAVY DASHED (---) SHALL BE REMOVED, ELECTRICAL ITEMS SHOWN HEAVY SOLID (—) SHALL BE NEW AND ELECTRICAL ITEMS SHOWN LIGHT SOLID (---) SHALL BE EXISTING TO REMAIN.

DRAWING NOTES:

- PROVIDE HOMERUN TO EXISTING SPARE CIRCUIT BREAKER SHOWN IN EXISTING PANEL 1L.
- TICKER SIGN PROVIDED BY OTHERS. PROVIDE POWER AND DATA CONNECTIONS.
- PROVIDE NEMA 5-20R RECEPTACLE FOR TICKER SIGN. COORDINATE LOCATION AND MOUNTING HEIGHT OF RECEPTACLE WITH TICKER SIGN PROVIDER/INSTALLER PRIOR TO INSTALLATION.
- PROVIDE DATA OUTLET FOR TICKER SIGN. COORDINATE LOCATION AND MOUNTING HEIGHT OF DATA OUTLET WITH TICKER SIGN PROVIDER/INSTALLER PRIOR TO INSTALLATION.
- WORLD CLOCK PROVIDED BY OTHERS.
- PROVIDE NEMA 5-20R RECEPTACLE FOR WORLD CLOCK. COORDINATE LOCATION AND MOUNTING HEIGHT OF RECEPTACLE WITH WORLD CLOCK PROVIDER/INSTALLER PRIOR TO INSTALLATION.
- PROVIDE DATA OUTLET FOR WORLD CLOCK. COORDINATE LOCATION AND MOUNTING HEIGHT OF DATA OUTLET WITH WORLD CLOCK PROVIDER/INSTALLER PRIOR TO INSTALLATION.
- PROVIDE UNDER CARPET FLOOR WIRE SYSTEM MANUFACTURED BY CONNECTRAC (2.7 SERIES) FROM WALL TO FLOOR BOX CONNECTIONS AS REQUIRED. SYSTEM SHALL INCLUDE (1) QUAD RECEPTACLE, (2) DATA CONNECTIONS, WIREWAY, UNDER CARPET RAMP, 24" WALL CHANNEL KIT, AND ALL ACCESSORIES. PROVIDE ALL COMPONENTS AND CONNECTIONS REQUIRED TO PROVIDE A COMPLETE AND OPERABLE SYSTEM. PROVIDE (2) CAT 6 FROM VOICE/DATA OUTLETS TO EXISTING 2nd FLOOR IT ROOM 209C. COORDINATE OUTLET BOX AND WIREWAY ROUTING LOCATION WITH OWNER AND FINAL FURNITURE LOCATION.
- PROVIDE DEVICE(S) FOR WALL MOUNTED PROJECTOR. COORDINATE LOCATION AND MOUNTING HEIGHT WITH PROJECTOR PROVIDER/INSTALLER.
- ELECTRONIC DOOR RELEASE DEVICE. REFER TO ELECTRONIC DOOR ACCESS SYSTEM CONNECTION DIAGRAM ON DRAWING E5.02 FOR ADDITIONAL INFORMATION.
- PROVIDE UNDER CARPET FLOOR WIRE SYSTEM MANUFACTURED BY CONNECTRAC (2.7 SERIES) FROM WALL TO FLOOR BOX CONNECTIONS AS REQUIRED. SYSTEM SHALL INCLUDE (1) QUAD RECEPTACLE, (4) DATA CONNECTIONS, WIREWAY, UNDER CARPET RAMP, 24" WALL CHANNEL KIT, AND ALL ACCESSORIES. PROVIDE ALL COMPONENTS AND CONNECTIONS REQUIRED TO PROVIDE A COMPLETE AND OPERABLE SYSTEM. PROVIDE (4) CAT 6 FROM DATA OUTLETS TO EXISTING 2nd FLOOR IT ROOM 209C. COORDINATE OUTLET BOX AND WIREWAY ROUTING LOCATION WITH OWNER AND FINAL FURNITURE LOCATION.
- PROVIDE SURFACE MOUNTED RECEPTACLE ON COLUMN. SUPPLY FROM CEILING USING SURFACE METAL RACEWAY. ROUTE SURFACE METAL RACEWAY FROM CEILING DOWN TO RECEPTACLE MOUNTED ON BACKSIDE OF COLUMN (I.E. ON WINDOW SIDE) SO THAT RACEWAY DROP IS NOT VISIBLE AS MUCH AS POSSIBLE.
- COORDINATE DEVICE LOCATION WITH COLLEGE IT PERSONNEL.
- COORDINATE DEVICE LOCATION WITH CASEWORK.
- MOUNT AT 80" A.F.F. COORDINATE FINAL MOUNTING HEIGHT WITH TV PROVIDER/INSTALLER.
- PROVIDE DEVICES FOR LECTERN. COORDINATE LOCATION OF DEVICES WITH THE OWNER.
- PROVIDE FIRE ALARM DEVICE CONNECTED TO EXISTING MAIN BUILDING FIRE ALARM SYSTEM.
- REMOVE, PROTECT, AND REINSTALL ALL CEILING MOUNTED ELECTRICAL AND SPECIAL SYSTEM DEVICES AS REQUIRED DUE TO CEILING WORK ON THIS AREA.
- MESSAGE BOARD DEVICE SUPPLIED BY OWNER AND INSTALLED BY CONTRACTOR. COORDINATE LOCATION WITH THE OWNER.
- EXTERIOR TICKER SIGN PROVIDED BY OTHERS. PROVIDE POWER AND DATA CONNECTIONS. REFER TO DRAWING E1.02 FOR ADDITIONAL INFORMATION.
- EXISTING CABLE RACEWAY PATH FROM GROUND FLOOR TO FIRST FLOOR AND FROM FIRST FLOOR TO SECOND FLOOR.
- CONNECTRAC UNDER CARPET WIREWAY.
- CONFERENCE ROOM SCHEDULING DEVICE SUPPLIED BY OWNER. PROVIDE JUNCTION BOX MOUNTED AT 48" AFF AND 1" CONDUIT FROM BOX TO ACCESSIBLE CEILING SPACE. PROVIDE (1) CAT 6 FROM EXISTING 2nd FLOOR IDF ROOM 209C TO OUTLET. COORDINATE BOX TYPE AND LOCATION WITH SYSTEM PROVIDER/INSTALLER.
- PROVIDE MONITOR MODULE FOR SPRINKLER FLOW/TAMPER SWITCH.

SEAL:

PROFESSIONAL CERTIFICATION:

PROFESSIONAL CERTIFICATION: I HEREBY CERTIFY THAT THESE DOCUMENTS WERE PREPARED OR APPROVED BY ME, AND THAT I AM A DULY LICENSED PROFESSIONAL ENGINEER UNDER THE LAWS OF THE STATE OF MARYLAND.
 LICENSE NO. 30474
 EXPIRATION DATE: 01/23/2021

ISSUED FOR:

DATE:	DESCRIPTION:
3/6/2020	100% CONSTRUCTION DOCUMENTS
3/25/2020	ADDENDUM #1

PROJECT NO: BKM # 19106.01

SCALE: AS NOTED

DRAWN BY: BKM

CHECKED BY: BKM


DATE: 03/06/2020

SHEET TITLE: FIRST FLOOR PLAN - POWER & SPECIAL SYSTEMS - NEW WORK


DRAWING NO:

E2.01


BKM# 19106.01

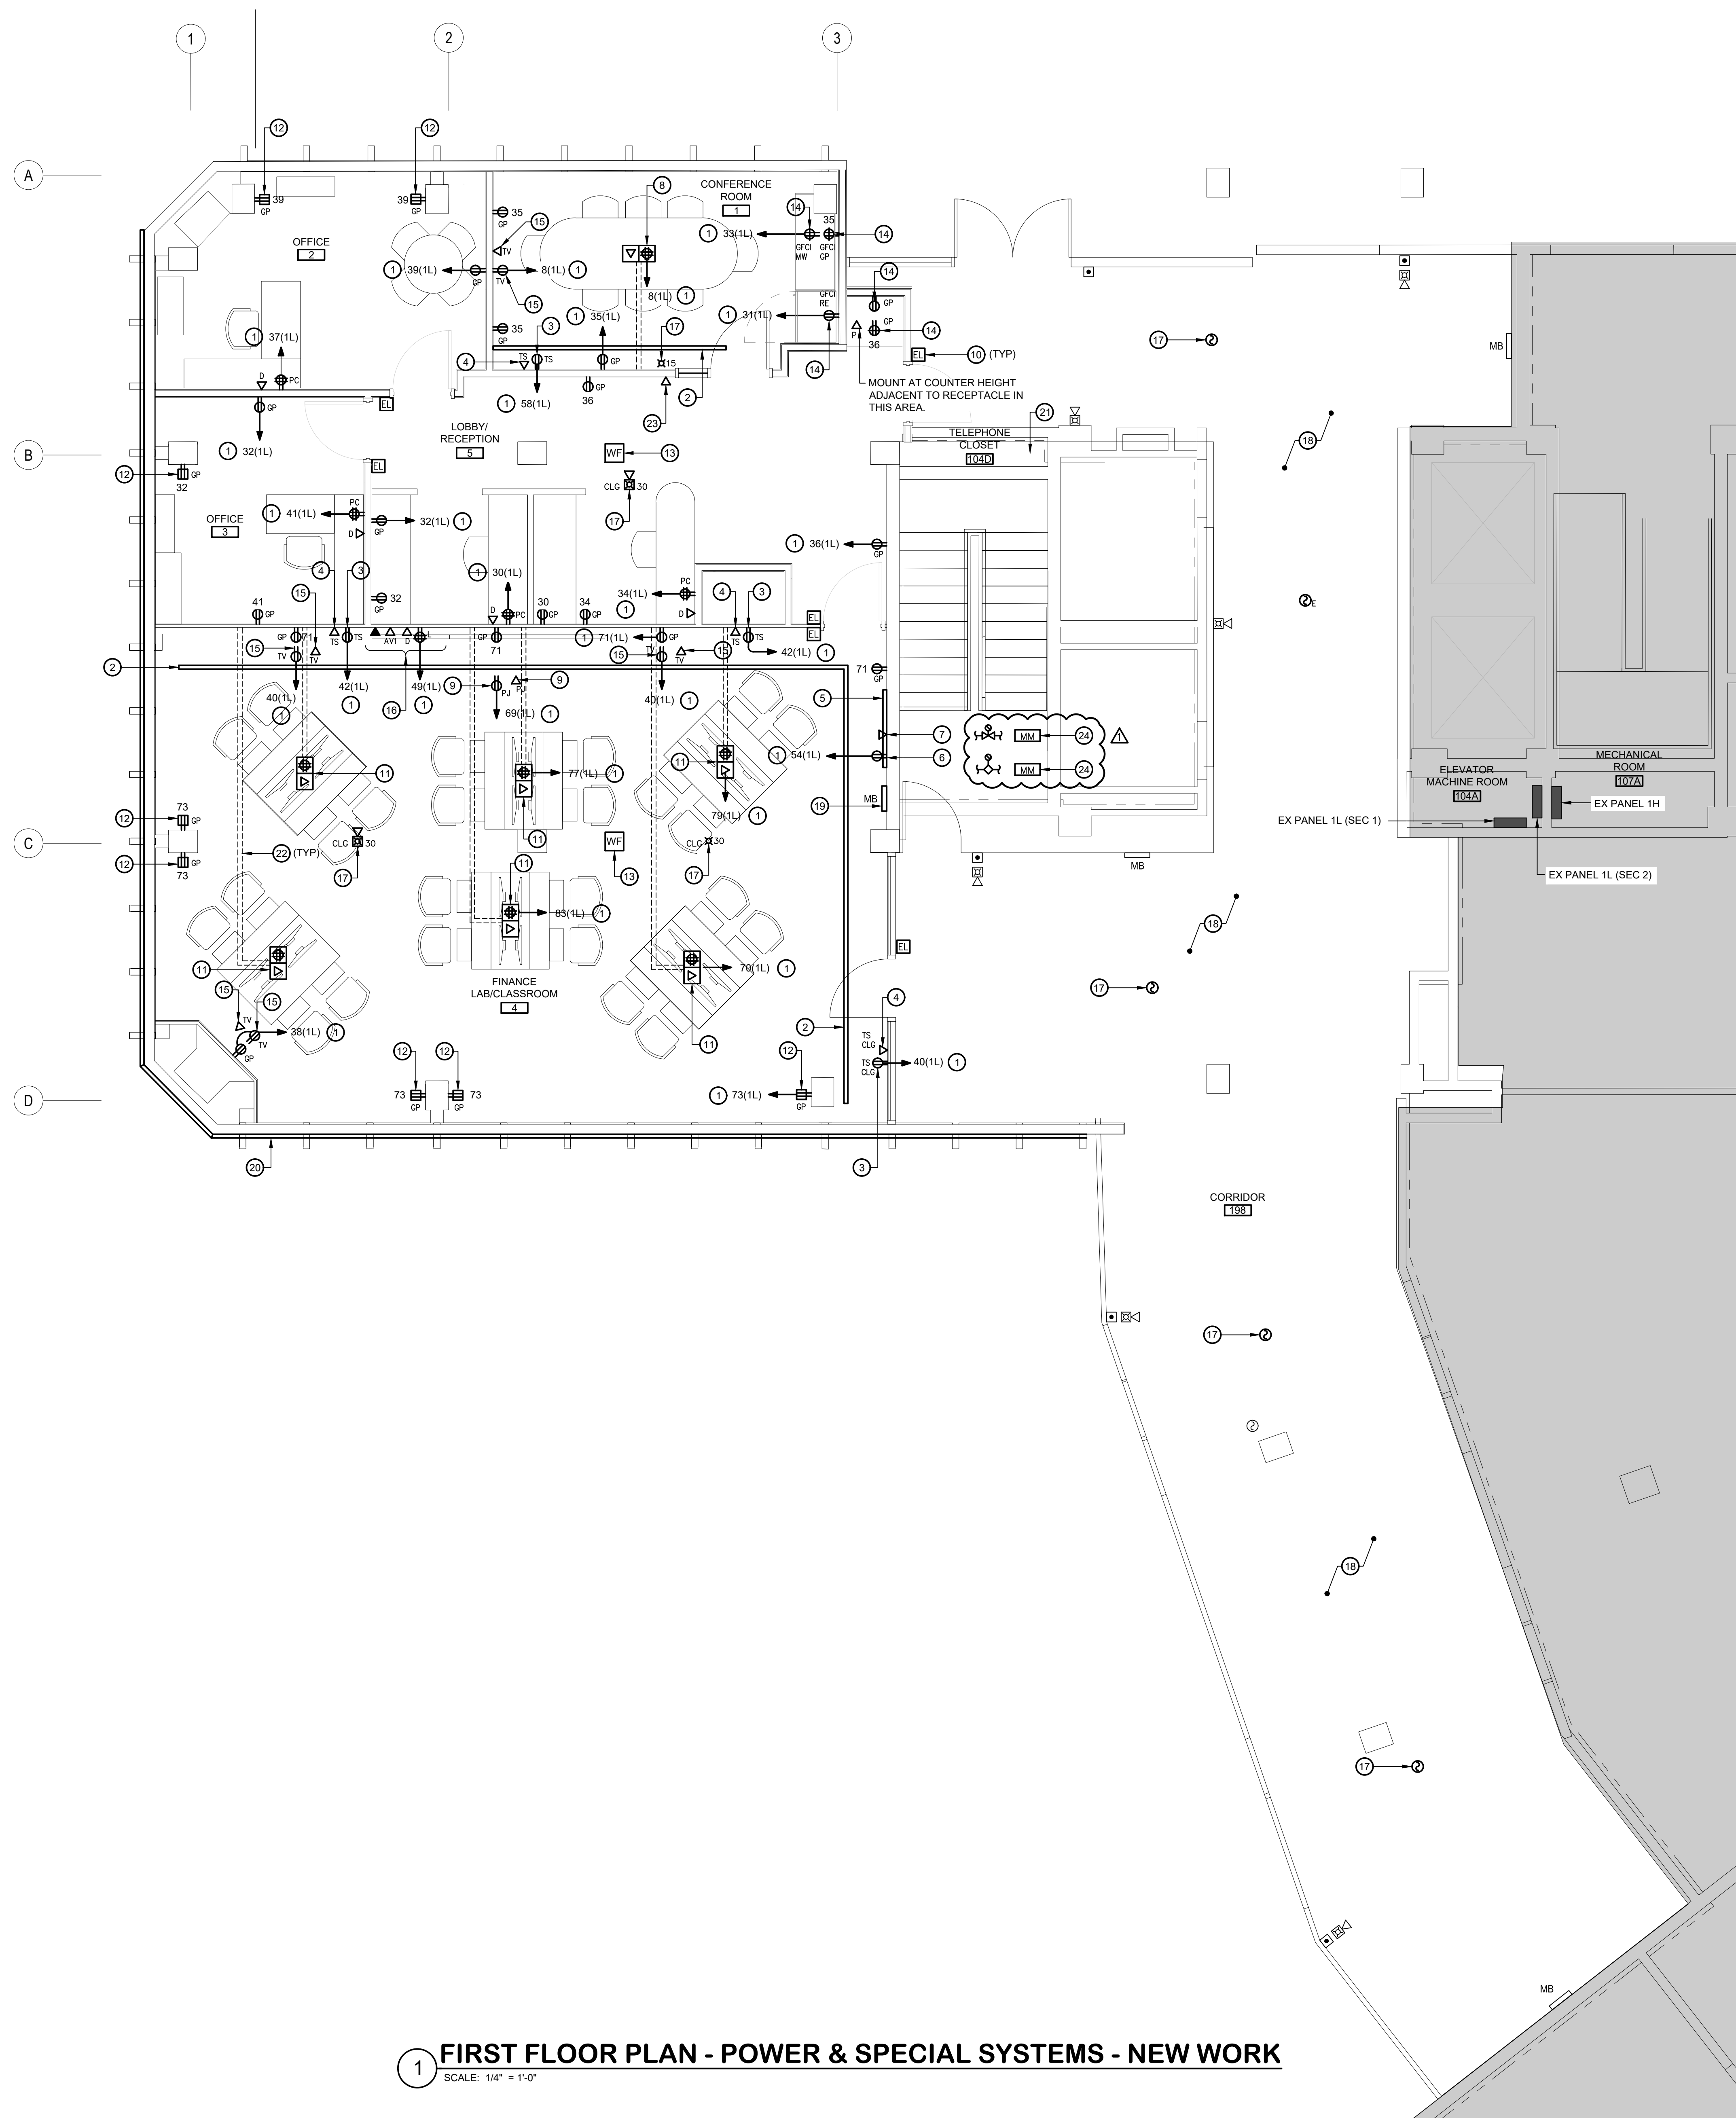

1 FIRST FLOOR PLAN - POWER & SPECIAL SYSTEMS - NEW WORK
 SCALE: 1/4" = 1'-0"

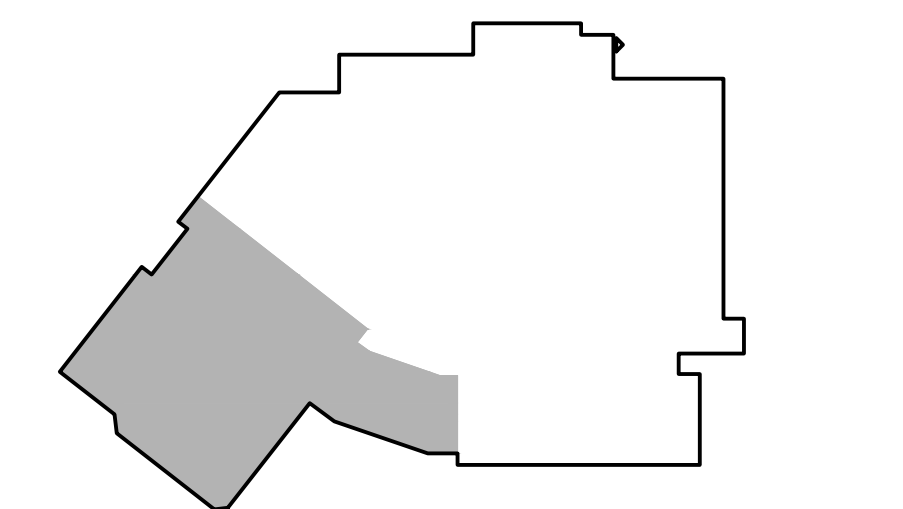

KEY PLAN
 NOT TO SCALE

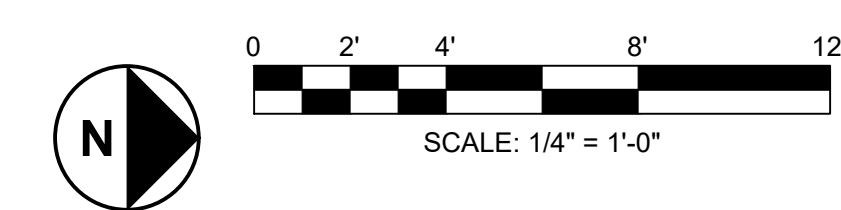

Addendum 1

Project:	MC RV MT MBI FINANCE LAB SUITE 100 RENOVATIONS	Date:	03/25/2020
		Reference:	
Title:	Addendum #1 Drawing Narrative	BKM Project No:	19106.01

COMMENTS:

General:

Cover Sheet

- Drawing Index has been updated to reflect the correct drawings included in the bid documents.
- Sheets with changes related to addendum #1 have been Identified.

G0.11 – Life Safety Plans

- The building height has been corrected to reflect the height from fire vehicle access to top occupiable floor.
- Notes regarding fire protections systems throughout the building have been revised.

Architectural:

A1.01 – Ground Floor Plan

- Wall sleeve and waterproofing notes added for new penetrations.

A1.12 – First Floor Reflected Ceiling Plan

- Classroom ceiling system has been modified to a cloud ceiling system.

A4.01 – Enlarged Plans and Elevations

- Enlarge Plan and Elevations have been revised.

A6.07 – Finish Schedules and Details

- Detail #6 – Transition Detail has been added.

Structural:

S1.01 – Plans and Elevations

- The louver opening has been relocated to reflect the new louver location.
- New penetrations have been provided for future conduit.

S2.02 – Sections and Details

- Wall opening detail has been revised.

Mechanical:

M0.01 “Mechanical Legend, Abbreviations, General Notes, Schedules and Details”

- General fire protection notes have been updated.
- Temporary heating and cooling requirements have been added to “General Notes”

M2.01 “Ground Floor Plan – Mechanical – New Work”

- The relief air louver and associated ductwork has been moved to accommodate future conduit penetrations.
- Temporary heating and cooling requirements have been indicated on the drawing.

M2.02 “First Floor Plan – Mechanical– New Work”

- Fire protection requirements in “General Notes” have been updated.
- Temporary heating and cooling requirements have been indicated on the drawing.

Plumbing:

P2.01 “First Floor Plan – Plumbing – New Work”

- Sprinkler Piping has been added throughout the project area.
- “Sprinkler Zone Assembly” detail has been added to show requirements for connection to existing standpipe.

Electrical:

E2.01 “First Floor Plan – Power & Special Systems – New Work”

- Note 24 has been added to provide monitor module for sprinkler flow/tamper switch.

Specifications:

23 73 10 – Indoor Packaged Air Handling Units

- Section 23 73 10 has been revised to reflect the basis of design air handling unit.

The related Drawings are attached with the changes clouded.
